

SIMPSON
Q5
12-66

MISSISSIPPI  
 BOARD OF WATER COMMISSIONERS  
 416 North State Street  
 Jackson, Mississippi 39201

CODED

WATER WELL DRILLERS LOG

Dec. 18 1966 W. H. Dallas Wellken SIMPSON  
 date well completed firm name county well located

LANDOWNER:  
Kenneth Balguy  
Magee  
 (mailing address)

description of formations encountered	from	to
<del>red clay</del>	<del>0</del>	<del>20</del>
<del>red sand</del>	<del>10</del>	<del>40</del>
<del>water sand</del>	<del>20</del>	<del>80</del>

WELL LOCATION:  
 sec 15 T 10 N R 17 E  
 S  
 (distance) 5 miles (direction) S of Forest (nearest town)

red clay	0	10
red sand	10	40
chalk	40	60
water sand	20	80

WELL PURPOSE:  
 (home, irrigation, municipal, industrial)

WELL COMPLETION DATA:

(1) diameter (inches) 2 in

(2) total depth (feet) 80

(3) static water level (feet) 60 below above top of ground.

(4) casing plastic, 15 ft  
 (material) (depth)  
 (size) if telescope see back.

(5) screen 5 ft, 20  
 (length) (depth to top)  
1 1/4, 60 gal  
 (size) (material)

(6) pump 1  
 (HP) (yield gpm)  
 (type power)

(7) electric log No  
 (yes or no)  
 (organization running log)


(8) how well bottom plugged

MISSISSIPPI  
 BOARD OF  
 WATER COMMISSIONERS

DRILLERS REMARKS:

If well telescopes please sketch and show depths.

GROUND LEVEL

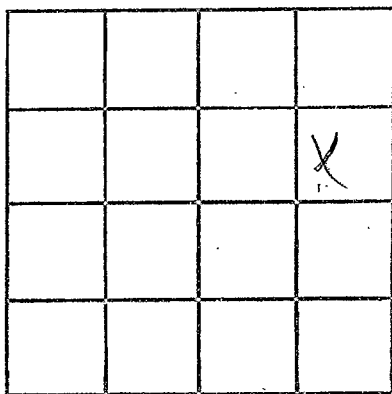

SECTION \_\_\_\_\_

Please indicate well location X.

ADDITIONAL INFORMATION

If more than one screen, show locations of each on sketch.