

SIMPSON
Q6
9-66

MISSISSIPPI
BOARD OF WATER COMMISSIONERS
416 North State Street
Jackson, Mississippi 39201

CODED

WATER WELL DRILLERS LOG

Sept 1966 date well completed
W.H. Dallas Well Drilling firm name
Simpson county well located

LANDOWNER:

Clayd Thomas
Magee

(mailing address)

description of formations encountered

	from	to
red clay & sand	0	40
chalk	40	180
water sand	180	204

WELL LOCATION:

sec 15 T 10 N R 17 E
S W Coats
miles 5 of (distance) (direction) (nearest town)

WELL PURPOSE:

(home, irrigation, municipal, industrial)

WELL COMPLETION DATA:

- (1) diameter (inches) 2 in
- (2) total depth (feet) 204
- (3) static water level (feet) 79 below above top of ground.
- (4) casing NONE (material), (depth)

(size) if telescope see back.

- (5) screen 12 ft (length) (depth to top)

1/4 (size) (material)

- (6) pump 3/4 (HP) (yield gpm)

(type power)

- (7) electric log no (yes or no)

(organization running log)


- (8) how well bottom plugged

DRILLERS REMARKS:

EX-100-1-1966
MISS. BOARD OF
WATER COMMISSIONERS

If well telescopes please sketch and show depths.

GROUND LEVEL

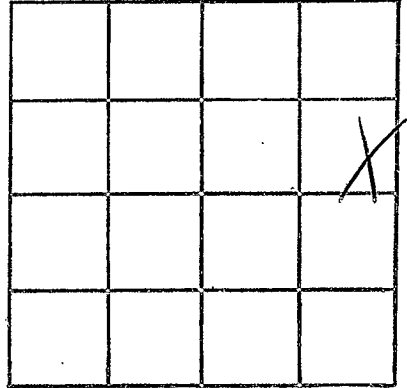

SECTION _____

Please indicate well location X.

ADDITIONAL INFORMATION

If more than one screen,
show locations of each on sketch.