

SIMPSON MISSISSIPPI BOARD OF WATER COMMISSIONERS

Q 7

7-28-62

WATER WELL DRILLERS LOG

CODED

Date: 7/28, 1962, Driller: Wesley Roberts County Simpson
 (Name)

(1) Owner of Land:	Description & Color of Materials Sand, Clay, Red Clay, Shell, etc.	Thick- ness Feet	Depth Feet
<u>Pete Williamson</u> (Name)	<u>Red Clay</u>	<u>10</u>	<u>10</u>
<u>Rt 2 Mound</u> (Address)	<u>Sand & Gravel</u>	<u>20</u>	<u>30</u>
(2) Location: <u>1/4</u> , <u>1/4</u> , Sec. <u>3</u> T <u>10R17</u>	<u>water sand</u>	<u>30</u>	<u>60</u>
<u>3</u> miles <u>E</u> , of <u>Mound</u> (distance) (direction) (Nearest Town)			
(3) Topography: <u>X</u> (Hilly) (Flat) (Level)			
(4) Purpose of Well: <u>Domestic</u> (Domestic Irrigation Municipal, Industrial, Other)			

CODED


Information upon completion of well:

- (1) Diameter 2 inches.
- (2) Total Depth 60 feet.
- (3) Water Level 30 feet below top of ground.
- (4) Cased to 55, Size 2"
- (5) Screen: Size 1/4, Length 5 ft
- (6) Were any formations sealed against pollution?
 yes, no.

If YES depth of formation _____

Why _____

Drillers Remarks: _____

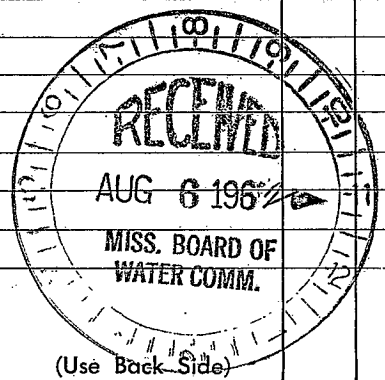

Well No

