

Q9

3-22-62

WATER WELL DRILLERS LOG

CODED

Date: 3/22, 1966, Driller: NEIL LUMPKIN County P.R.

(Name)

(1) Owner of Land: DICK BROOKS
(Name)

MAGEE, MISS.
(Address)

(2) Location: 1/4, 1/4, Sec. 17 T. R.

3 1/2 miles SOUTH of MAGEE
(distance) (direction) (Nearest Town)

(3) Topography: HILLY
(Hilly) (Flat) (Level)

(4) Purpose of Well: DOMESTIC
(Domestic Irrigation
Municipal, Industrial, Other)

Description & Color of Materials
Sand, Clay, Red Clay, Shell, etc.

Thick-
ness
Feet

Depth
Feet

SURFACE CLAY 0 10
SAND 10 151

CODED

Information upon completion of well:

(1) Diameter 2 inches.

(2) Total Depth 151 feet.

(3) Water Level 120 feet below top of ground.

(4) Cased to _____, Size _____

(5) Screen: Size 2", Length 5'


(6) Were any formations sealed against pollution?

_____ yes, ✓ no.

If YES depth of formation _____

Why _____

Drillers Remarks: _____

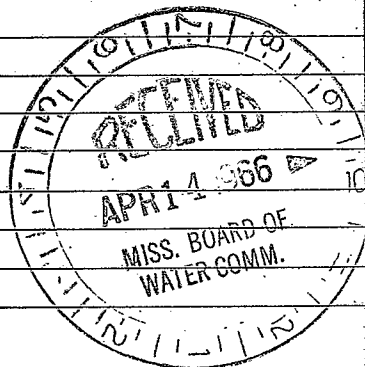

(Use Back Side)

Well No.

