

Q-10
8-2-60

WATER WELL DRILLERS LOG

Date: Aug 2, 1960, Driller: James A. [unclear]
(Name)

CODED
County: [unclear]

(1) Owner of Land: Preston Allen
(Name)
Margee [unclear]
(Address)

(2) Location: 1/4, 1/4, Sec. 10 T. 10N R. 17W
3 miles East of Margee
(distance) (direction) (Nearest Town)

(3) Topography: X
(Hilly) (Flat) (Level)

(4) Purpose of Well: Children Farm
(Domestic Irrigation
Municipal, Industrial, Other)

Description & Color of Materials Sand, Clay, Red Clay, Shell, etc.	Thick- ness Feet	Depth Feet
<u>20 ft Red Clay</u>	<u>2.0</u>	
<u>Shred</u>	<u>3.0</u>	
		<u>50</u>

Information upon completion of well:

(1) Diameter 2 inches.


(2) Total Depth 50 feet.

(3) Water Level 42 feet below top of ground.

(4) Cased to 54, Size 2

(5) Screen: Size 1/2", Length 6

(6) Were any formations sealed against pollution?
_____ yes, X no.

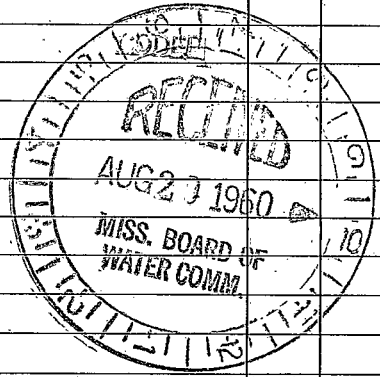

If YES depth of formation _____

Why _____

Drillers Remarks: _____

(Use Back Side)

Well No.

