

Retained 2/2/69

Entered 3/13/69

Simpson
Q 14
12-68

MISSISSIPPI
BOARD OF WATER COMMISSIONERS
416 North State Street
Jackson, Mississippi 39201

OKger

CODED

CODED

WATER WELL DRILLERS LOG

Dec 12, 1968
date well completed

K. E. Thompson
firm name

Simpson
county well located

LANDOWNER:
W. W. L. L. L. L.
Major Miss.
(mailing address)

description of formations encountered

from to

WELL LOCATION:
sec. 18 T. 10 N. R. 17 W.
miles of (distance) (direction) (nearest town)

Drilled & Re-drilled

WELL PURPOSE:
(home, irrigation, municipal, industrial)

WELL COMPLETION DATA:

- (1) diameter (inches) 2'
- (2) total depth (feet) 132
- (3) static water level (feet) 96' below top of ground.
- (4) casing Gal, 133 (material), (depth)
2' (size) if telescope see back.
- (5) screen 5', 132 (length), (depth to top)
1 1/2 (size), (material)
- (6) pump 3/4, 3 (HP), (yield gpm)
Auto (type power)
- (7) electric log no (yes or no)

CODED

CODED

(organization running log)


(8) how well bottom plugged

FEB 12 1969
MISS. DIV. OF
WATER CONTROL

DRILLERS REMARKS:

If well telescopes please sketch and show depths.

GROUND LEVEL

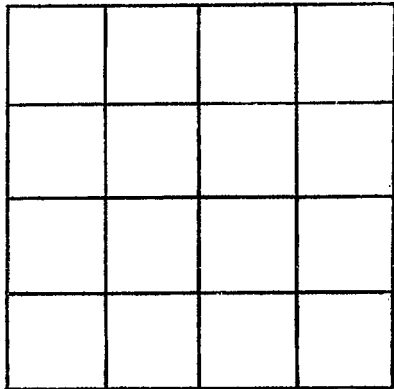

SECTION _____

Please indicate well location X.

ADDITIONAL INFORMATION

If more than one screen, show locations of each on sketch.