

Simpson  
Q 15  
10-70

MISSISSIPPI  
BOARD OF WATER COMMISSIONERS  
416 North State Street  
Jackson, Mississippi 39201

**CODED**

WATER WELL DRILLERS LOG

Oct 19 70 Erwin Drilling Service Inc. Simpson  
date well completed firm name county well located

LANDOWNER: City of Magee

description of formations encountered	from	to
	<u>Top Soil</u>	<u>0</u>
<u>Clay</u>	<u>2</u>	<u>10</u>
<u>SAND AT 10 FEET</u>	<u>10</u>	<u>97</u>

(mailing address)

WELL LOCATION:  
sec. 5 T. 10N S R. 17W E W  
miles \_\_\_\_\_ of \_\_\_\_\_  
(distance) (direction) (nearest town)

WELL PURPOSE: Municipal  
(home, irrigation, municipal, industrial)

WELL COMPLETION DATA:

- (1) diameter (inches) 18"
- (2) total depth (feet) 96'
- (3) static water level (feet) 25 below above top of ground.
- (4) casing Steel, 58',  
(material) (depth)  
18"  
(size) if telescope see back.
- (5) screen 30', 66'  
(length) (depth to top)  
10", 5.5.  
(size) (material)
- (6) pump 40 500  
(HP) (yield gpm)  
Elec.  
(type power)
- (7) electric log yes  
(yes or no)  
MIS  
(organization running log)
- (8) how well bottom plugged Back  
WASH WATER

**CODED**


SEP 24 1970

MISS. BD. OF  
WATER COMM.

DRILLERS REMARKS:

If well telescopes please sketch and show depths.

GROUND LEVEL

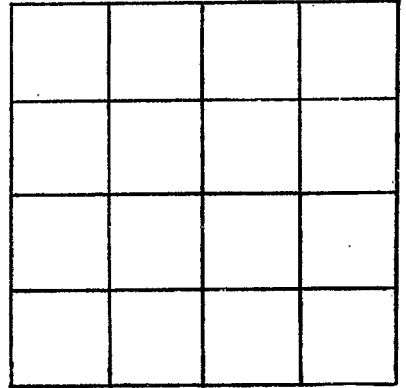

SECTION \_\_\_\_\_

Please indicate well location X.

ADDITIONAL INFORMATION

If more than one screen, show locations of each on sketch.