

SIMPSON
 Q 16
 10-26-70

MISSISSIPPI
 BOARD OF WATER COMMISSIONERS
 416 North State Street
 Jackson, Mississippi 39201

CODED

WATER WELL DRILLERS LOG

10-26 date well completed 1970 McWILLIAMS, W.W.S. SIMPSON firm name county well located

LANDOWNER: J. W. PARISH
 Rt. 4.
 MOBILE MISS
 (mailing address)
 WELL LOCATION:
 sec. 22 T. 10 N R. 17 E
 3 1/2 miles N of MOBILE
 (distance) (direction) (nearest town)

description of formations encountered	from	to
CLAY	0	15
YELLOW SAND	15	35
CRACK	35	48
REE GRAVLE	42	54
WATER SAND	52	70

WELL PURPOSE: HOME
 (home, irrigation, municipal, industrial)

- WELL COMPLETION DATA:
- (1) diameter (inches) 2"
 - (2) total depth (feet) 70
 - (3) static water level (feet) 50 below top of ground.
 - (4) casing GALV (material), 66 (depth),
 (size) If telescope see back.
 - (5) screen 5 FT (length), (depth to top)
 7.50" STAINLESS STEEL (size) (material)
 - (6) pump 1 (HP), 400 (yield gpm)
 ELECTRIC (type power)
 - (7) electric log (yes or no)
 - (organization running log)
 - (8) how well bottom plugged 1/2 PLUG

CODED


APR 27 1971

MISS. BD. OF WATER COMMISSIONERS

DRILLERS REMARKS:

If well telescopes please sketch and show depths.

GROUND LEVEL

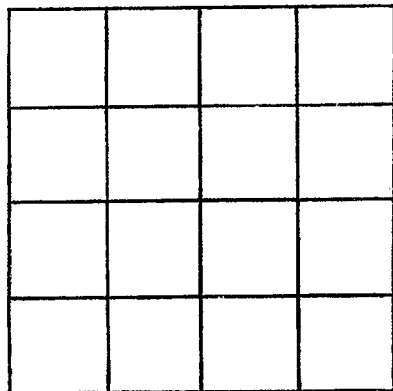

SECTION _____

Please indicate well location X.

ADDITIONAL INFORMATION

If more than one screen, show locations of each on sketch.