

SIMPSON

MISSISSIPPI BOARD OF WATER COMMISSIONERS

Q18

4-18-62 #76

WATER WELL DRILLERS LOG

CODED

Date: 4/18, 1962, Driller: Wayne White County Simpson (Name)

(1) Owner of Land: James E. Smith (Name) Rt 2 Magnolia, Miss (Address)

(2) Location: 1/4, 1/4, Sec 25 T10 R17, 7 (9) miles N.W. of Magnolia (distance), (direction), (Nearest Town)

(3) Topography: (Hilly) (Flat) (Level)

(4) Purpose of Well: (Domestic Irrigation Municipal, Industrial, Other)

Description & Color of Materials Sand, Clay, Red Clay, Shell, etc.	Thick- ness Feet	Depth Feet
Red Clay	15	15
red gravel	15	30
pink Chalk	12	42
Sand	33	75
zirconia Sand	15	90

Information upon completion of well:

- (1) Diameter 2 inches.
- (2) Total Depth 90 feet.
- (3) Water Level 75 feet below top of ground.
- (4) Cased to 84, Size 2"
- (5) Screen: Size 1/4, Length 5
- (6) Were any formations sealed against pollution?


yes, no.

If YES depth of formation

Why

Drillers Remarks:

CODED

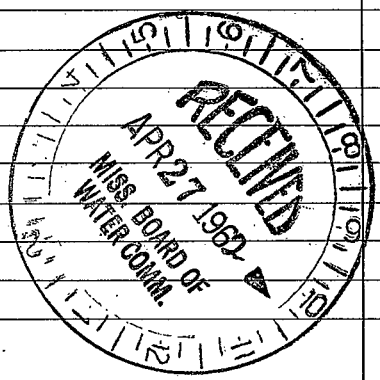

(Use Back Side)

Well

