

MISSISSIPPI DEPARTMENT OF NATURAL RESOURCES

Bureau of Land and Water Resources

Southport Mall

P.O. Box 10631

Jackson, Mississippi 39209

**CODED**

WATER WELL DRILLERS LOG

Griner Drilling Service, Inc.

Simpson

Simpson  
Q 21  
8-1-81  
8-7-81

date well completed 19

firm name

county well located

LANDOWNER:  
Pruett Production  
1515 Capital Towers  
Jackson, MS 39205  
(mailing address)

description of formations encountered	from	to
top dirt-fill	0	21
chalk-rock	21	231
chalk streaked	231	600
sand	600	650

WELL LOCATION: 19.30 S + 195.1 E  
sec. 1 T 10 N R 17 E of  
NO. 1 Wells Keys 1-6 miles (distance) of (nearest town)

WELL PURPOSE: oil field supply  
(home, irrigation, municipal, industrial)

- WELL COMPLETION DATA:
- (1) diameter (inches) 3"
  - (2) total depth (feet) 650'
  - (3) static water level (feet) 200'  below  above top of ground.
  - (4) casing steel, 650'  
(material) (depth)  
3"  
(size) If telescope see back.
  - (5) screen 42', 608'  
(length) (depth to top)  
3" perforated  
(size) (material)
  - (6) pump 70  
(HP) (yield gpm)  
AC  
(type power)
  - (7) electric log —  
(yes or no)  
—  
(organization running log)
  - (8) how well bottom plugged orange peel

DRILLERS REMARKS:


DEPT. OF NATURAL RESOURCES  
BUREAU OF LAND & WATER RESOURCES

SEP 28 1981

RECEIVED

If well telescopes please  
sketch and show depths.

GROUND LEVEL

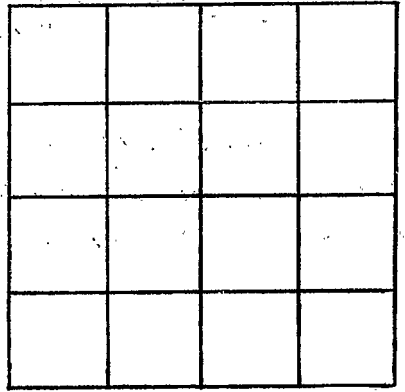

SECTION \_\_\_\_\_

Please indicate well location X.

ADDITIONAL INFORMATION

If more than one screen,  
show locations of each on sketch.