

MISSISSIPPI DEPARTMENT OF NATURAL RESOURCES

Bureau of Land and Water Resources

Southport Mall

P.O. Box 10631

Jackson, Mississippi 39209

WATER WELL DRILLERS LOG

CODED

Griner Drilling Service, Inc

Simpson

Simpson
Q 22
12/23/81

9

12-23-81 date well completed

Griner Drilling Service, Inc firm name

Simpson county well located

LANDOWNER:	description of formations encountered	from	to
<u>Druet Production</u> <u>1515 Capital Towers</u> <u>Jackson, MS 39120</u> (mailing address)	<u>SAND</u>	<u>0</u>	<u>63</u>
WELL LOCATION: <u>210'S + 33'W</u> sec. <u>2</u> T. <u>10N</u> R. <u>17</u> NE/40 <u>No. 1 Yeverton Mageefield</u> (distance) miles (direction) of (nearest town)	<u>sand, chalk on bottom</u>	<u>63</u>	<u>84</u>
WELL PURPOSE: <u>oil field supply</u> (home, irrigation, municipal, industrial)	<u>streaked</u>	<u>84</u>	<u>147</u>
WELL COMPLETION DATA:	<u>chalk</u>	<u>147</u>	<u>189</u>
(1) diameter (inches) <u>4"</u>	<u>chalk, 10' sand</u>	<u>189</u>	<u>210</u>
(2) total depth (feet) <u>420'</u>	<u>10' sand, chalk</u>	<u>210</u>	<u>231</u>
(3) static water level (feet) <u>100'</u> (below/above top of ground)	<u>chalk</u>	<u>231</u>	<u>315</u>
(4) casing <u>steel</u> , <u>378'</u> (material) (depth)	<u>streaked, 10' sand</u>	<u>315</u>	<u>357</u>
<u>4"</u> (size) if telescope see back.	<u>sand</u>	<u>357</u>	<u>399</u>
(5) screen <u>42'</u> , <u>336'</u> (length) (depth to top)	<u>chalk</u>	<u>399</u>	<u>420</u>
<u>4"</u> (size) <u>perforated</u> (material)			
(6) pump <u>—</u> , <u>70</u> (HP) (yield gpm)			
(type power)			
(7) electric log <u>—</u> (yes or no)			
(organization running log)			
(8) how well bottom plugged <u>orange</u>			
<u>peel</u>			
DRILLERS REMARKS:			

CODED


DEPT. OF NATURAL RESOURCES
BUREAU OF LAND & WATER RESOURCES

JAN 15 1982

RECEIVED

If well telescopes please sketch and show depths.

GROUND LEVEL

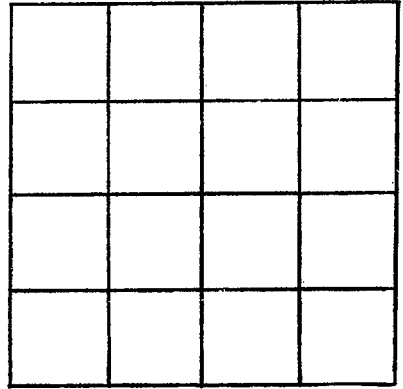

SECTION _____

Please indicate well location X.

ADDITIONAL INFORMATION

If more than one screen, show locations of each on sketch.