

MISSISSIPPI DEPARTMENT OF NATURAL RESOURCES

Bureau of Land and Water Resources

Southport Mall

P.O. Box 10631

Jackson, Mississippi 39208

WATER WELL DRILLERS LOG

TOM GRIFFITH
DRILLING & WELL SERVICE, INC.

Simpson
county well located

SIMPSON
Q 23
8/16/82

8/16 date well completed

firm name

county well located

LANDOWNER:

description of formations encountered

from

to

Mangum, 2-1
Pratt Production
1515 Capital Tower
Jackson (mailing address) Miss 39201

Sand + clay	0	200
Chalk (Hard)	200	480
Sand + Pea gravel	480	580

WELL LOCATION:

sec. 2 T. 10 N R. 17 E
S W
5 miles E Magee Miss.
(distance) (direction) (nearest town)

WELL PURPOSE: oil well
(home, irrigation, municipal, industrial)

WELL COMPLETION DATA:

- (1) diameter (inches) 3"
- (2) total depth (feet) 580
- (3) static water level (feet) 200' below top of ground.
- (4) casing Steel (material) (depth)
- (5) screen 10' wire 20' slot (length) (depth to top)
3" (size) Steel (material)
- (6) pump 70HP (HP) 65 (yield gpm)
Electric air (type power)
- (7) electric log NO (yes or no)
n/a (organization running log)
- (8) how well bottom plugged plugged

820' S E 500' W
NE cor, Sect. 2, 10N
17 W

CODED

DEPT. OF NATURAL RESOURCES
BUREAU OF LAND & WATER RESOURCES


SEP 29 1982

RECEIVED

DRILLERS REMARKS:

If well telescopes please sketch and show depths.

GROUND LEVEL

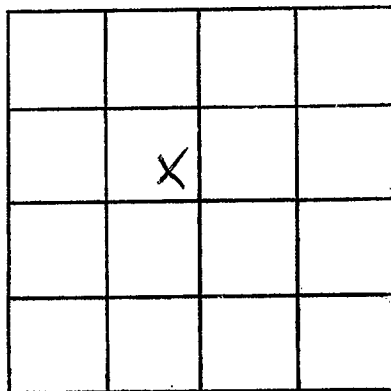

SECTION _____

Please indicate well location X.

ADDITIONAL INFORMATION

If more than one screen, show locations of each on sketch.