

# State Well Report

## Part 1 - Driller's Log

Mississippi Department of Environmental Quality  
Office of Land and Water Resources  
P.O. Box 2309  
Jackson, MS 39225  
(601)961- 5210  
(601)961- 5228 (fax)

County: Simpson  
Permit #: 0-586  
Driller: JAMES WELLS  
Date drilling completed: 2-20-09

For Office Use Only:  
Aquifer: \_\_\_\_\_  
Well #: Q-64  
L. S. Elevation: \_\_\_\_\_  
E-log #: \_\_\_\_\_

State Law requires that this report be prepared by the license holder responsible for the work and filed with the Department at the above address within 30 days of completion of drilling of the well or borehole.

Information on Well Owner (Landowner if borehole is not for a water well)	Well or Borehole Location
Owner Name: <u>Steve Maddox</u>	Latitude: _____° _____' _____" Longitude: _____° _____' _____"
Mailing Address: <u>136 J. Smith Rd.</u>	Method of Lat/Long (circle one): <input type="checkbox"/> Conventional Survey, <input type="checkbox"/> USGS quad, <input type="checkbox"/> Hand-held GPS, <input type="checkbox"/> Survey-grade GPS
<u>Magee MS 39111</u>	_____ 1/4 _____ 1/4 Sec <u>14</u> Twn <u>10N</u> Rng <u>17E</u>
City State Zip Code	Distance Direction Nearest Town
Telephone No. <u>(601) 906-7832</u>	<u>6</u> Miles <u>SE</u> of <u>Magee</u> <u>6E</u>

**Well / Borehole Data**

Date drilling started: 2-20-09 Date drilling completed: 2-20-09 Hole depth: 90 Hole diameter: 7

Location of the source of any surface water used for drilling: Creek Water

Method of dosing and volume of Chlorine used in drilling and development: 3 lb Shock

Logs run (circle all applicable):  No log run  Electric  Gamma Ray  Density  Sonic  Neutron Other: \_\_\_\_\_

Name of organization running log(s): \_\_\_\_\_

Purpose of borehole (check one): Water Well  Geotechnical/Geological Investigation  Ground Source Heat Pump   
Seismic Survey  Other (describe) \_\_\_\_\_

*If drilling is not related to water well construction, skip the remainder of this block*

Purpose of Well (check one): Home  Industrial  Public Supply  Irrigation  Fish Culture  Other: \_\_\_\_\_

If a flowing well, method of flow regulation: Valve \_\_\_\_\_ Other (describe) \_\_\_\_\_

Static Water Level: 15 feet above or  below (circle one) land surface Date measured: 2-20-09

Method of Measurement (circle one)  steel tape  electric tape  air line other: \_\_\_\_\_

Well depth: 90 Well grouted to a depth of 70 feet Type of grout (circle one):  Neat Cement  Bentonite  Mix

Casing length: 60 feet Casing diameter: 4 inches Type of casing: PVC

Screen length: 30 feet Screen diameter: 4 inches Type of screen: PVC

Screen slot size: .008 inches Setting depth: From 60 feet to 90 feet

Type of completion (circle all applicable):  Gravel packed  Underreamed  Telescoped  Open hole  Natural Development

Other (describe): \_\_\_\_\_

Top of lap pipe or reduction in casing: \_\_\_\_\_ feet. *If telescoped or more than one screen, describe on next page*

Form: OLWR-SWR-1A (04/08)

RECEIVED


MAR 09 2009

BY: OLWR

The sketch below only required for water wells

Description of formations encountered must be provided for all wells and boreholes, unless specifically exempted by regulations

If well telescopes, show depths on sketch.

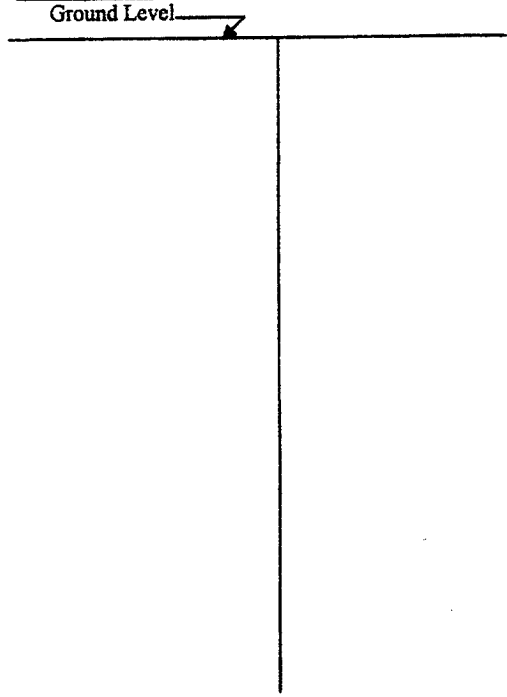

Description of Formations Encountered	From (depth) Ground Level	To (depth)
clay	2	20
Sand	20	40
Per Sand	40	80

If more than one screen, show location of each on sketch

Sketch the property layout and include the following: 1) the well location; 2) any permanent structures on the property that may aid in locating the well; 3) any roads, power lines, or other items that may aid in locating the property and the well; 4) a north arrow.

Landowner Name: Steve Maddox

I certify that the well/borehole was drilled, constructed, and completed in accordance with all applicable requirements of the Mississippi Department of Environmental Quality and the Mississippi Department of Health regulations, if applicable, and state laws.

JAMES WELLS 0-586  
Print Name of Responsible Licensee and License No.                      Date

James Wells  
Signature of Licensee

**RECEIVED**  
MAR 09 2009  
BY: OLWR

# STATE WELL REPORT

## Part 2

**Pump Installer's Completion Report**  
 Mississippi Department of Environmental Quality  
 Office of Land and Water Resources  
 P.O. Box 2309  
 Jackson, MS 39225  
 (601)961-5210  
 (601)961-5228 (fax)

County: Simpson  
 Permit #: \_\_\_\_\_  
 Driller: JAMES WELLS  
 Date completed: 2-20-09  
*Copy information from block on Part 1*

For Office Use Only:

Aquifer: \_\_\_\_\_  
 Well #: Q-64  
 Elevation: \_\_\_\_\_

*This part of the report must be completed by a licensed water well contractor or a licensed pump installer. A copy of Part 1 of the report must be attached and both parts filed with the Department at the above address within 30 days of well completion.*

Well Owner Information	Well Location
Owner Name: <u>Steve Maddox</u>	Latitude: _____ Longitude: _____
Mailing Address: <u>136 S. Smith Rd.</u>	Method of Lat/Long (check one): Conventional Survey _____
<u>Magee</u> MS <u>39111</u>	USGS quad _____ Hand-held GPS _____ Survey-grade GPS _____
City State Zip Code	_____ 1/4 _____ 1/4 Sec <u>14</u> T <u>10h</u> R <u>7W</u>
Telephone No. <u>(601) 906-7832</u>	Distance Direction Nearest Town
	<u>6</u> Miles <u>SE</u> of <u>Magee</u>

Pump Type Circle one	Power Type Circle one
Air Lift Jet <input checked="" type="radio"/> <u>Submersible</u>	Diesel Engine Gasoline Engine Natural Gas
Bucket Piston Turbine	<input checked="" type="radio"/> <u>Electric Motor</u> Hand Tractor PTO
Centrifugal Rotary Flowing Well	Windmill Other (specify): _____
Other (specify): _____	Horse Power Rating of Motor: <u>5</u>
Date Pump Installed: <u>2-20-09</u>	Setting Depth: <u>60</u> feet
Rated Pump Capacity: <u>60</u> Gallons Per Minute	Number of Stages: <u>13</u>

Pump Test Data	Method of Measuring Water Level Circle one
Date Well Tested: <u>2-20-09</u>	Air Line Electric Measuring Line <input checked="" type="radio"/> <u>Steel Tape</u>
Static Water Level (A): <u>15</u> Feet Below Land Surface	Other (specify): _____
Pumping Water Level (B): <u>60</u> Feet Below Land Surface	For flowing well, measured shut in head: _____ feet
Drawdown [(B) - (A)]: <u>40</u> Feet Below Land Surface	Well yielded <u>60</u> GPM with a drawdown of
Test Pumping Rate: <u>60</u> Gallons Per Minute	<u>15</u> feet after <u>4</u> hours of pumping
Duration of Pump Test (minimum 4 hours): <u>4</u> hours	

I HEREBY CERTIFY that the above statements are true to the best of my knowledge.

JAMES WELLS 0-586 James Wells  
 Print Name of Pump Installer and License No. (if applicable) Signature of Pump Installer

Form: OLWR-SW28-01B (0-07-08)  
**RECEIVED**  
 MAR 09 2009  
 BY: OLWR