

State Well Report

Part 1 - Driller's Log

Mississippi Department of Environmental Quality
Office of Land and Water Resources
P.O. Box 2309
Jackson, MS 39225
(601)961- 5210
(601)961- 5228 (fax)

For Office Use Only

Aquifer: Q 71
Well #:
L. S. Elevation:
E-log #:

County: SIMPSON
Permit #: 0-586
Driller: JAMES WELLS
Date drilling completed: 10-8-09

State Law requires that this report be prepared by the license holder responsible for the work and filed with the Department at the above address within 30 days of completion of drilling of the well or borehole.


Information on Well Owner (Landowner if borehole is not for a water well)
Owner Name: Twin Hillside Farms
Mailing Address: 124 Asape Ln.
City: Magee MS 39111
Well or Borehole Location
Latitude: 31.52.08 Longitude: 89.4423
Method of Lat/Long (circle one): Conventional Survey,
USGS quad, Hand-held GPS, Survey-grade GPS
IR 1/4 IR 1/4 Sec 216 Twn 10N Rng 6E
Distance 5 Miles Direction S of Nearest Town Magee

Well / Borehole Data
Date drilling started: 10-8-09 Date drilling completed: 10-8-09 Hole depth: 125 Hole diameter: 7 1/2
Location of the source of any surface water used for drilling: water well
Method of dosing and volume of Chlorine used in drilling and development: shack
Logs run (circle all applicable): No log run Electric Gamma Ray Density Sonic Neutron Other:
Name of organization running log(s):
Purpose of borehole (check one): Water Well X Geotechnical/Geological Investigation Ground Source Heat Pump
Seismic Survey Other (describe)
If drilling is not related to water well construction, skip the remainder of this block
Purpose of Well (check one): Home Industrial Public Supply Irrigation Fish Culture Other: chicken house
If a flowing well, method of flow regulation: Valve Other (describe)
Static Water Level: 70 feet above or below (circle one) land surface Date measured: 10-8-09
Method of Measurement (circle one) steel tape electric tape air line other:
Well depth: 125 Well grouted to a depth of 10 feet Type of grout (circle one): Neat Cement Bentonite Mix
Casing length: 95 feet Casing diameter: 4 inches Type of casing: PVC
Screen length: 30 feet Screen diameter: 4 inches Type of screen: PVC
Screen slot size: .008 inches Setting depth: From 95 feet to 125 feet
Type of completion (circle all applicable): Gravel packed Underreamed Telescoped Open hole Natural Development
Other (describe):
Top of lap pipe or reduction in casing: feet. If telescoped or more than one screen, describe on next page

Q 71

The sketch below only required for water wells

If well telescopes, show depths on sketch.

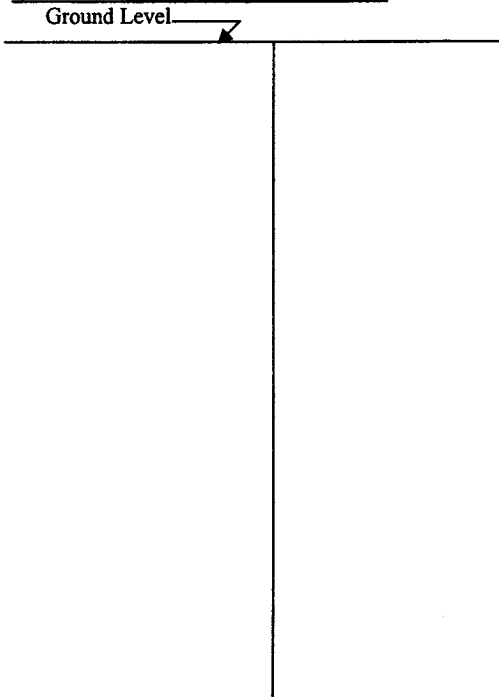

Description of formations encountered must be provided for all wells and boreholes, unless specifically exempted by regulations

Description of Formations Encountered	From (depth)	To (depth)
to soil	Ground Level	1
clay	1	75
sand	75	125

If more than one screen, show location of each on sketch

Sketch the property layout and include the following: 1) the well location; 2) any permanent structures on the property that may aid in locating the well; 3) any roads, power lines, or other items that may aid in locating the property and the well; 4) a north arrow.

Landowner Name: Twin Hillside Farms

Form: OLWR-SWR-1A (04/08)

I certify that the well/borehole was drilled, constructed, and completed in accordance with all applicable requirements of the Mississippi Department of Environmental Quality and the Mississippi Department of Health regulations, if applicable, and state laws.

JAMES WELLS 0-586
Print Name of Responsible Licensee and License No.

James Wells
Signature of Licensee

Date

STATE WELL REPORT

Part 2

Pump Installer's Completion Report
 Mississippi Department of Environmental Quality
 Office of Land and Water Resources
 P.O. Box 2309
 Jackson, MS 39225
 (601)961-5210
 (601)961-5228 (fax)

County: Simpson
 Permit #: _____
 Driller: JAMES WELLS
 Date completed: 10-8-09
Copy information from block on Part 1

For Office Use Only:

Aquifer: Q 71
 Well #: _____
 Elevation: _____

This part of the report must be completed by a licensed water well contractor or a licensed pump installer. A copy of Part 1 of the report must be attached and both parts filed with the Department at the above address within 30 days of well completion.

Well Owner Information	Well Location
Owner Name: <u>Twin Hillside Farms</u>	Latitude: _____ Longitude: _____
Mailing Address: <u>124 Asape Ln.</u>	Method of Lat/Long (check one): Conventional Survey _____
<u>Magee</u> MS <u>39111</u>	USGS quad _____, Hand-held GPS _____, Survey-grade GPS _____
City State Zip Code	_____ 1/4 _____ 1/4 Sec <u>21</u> T <u>10N</u> R <u>6E</u>
Telephone No. () _____	Distance Direction Nearest Town
	<u>5</u> Miles <u>5</u> of <u>Magee</u>

Pump Type Circle one	Power Type Circle one
Air Lift Jet <input checked="" type="radio"/> Submersible	Diesel Engine Gasoline Engine Natural Gas
Bucket Piston Turbine	<input checked="" type="radio"/> Electric Motor Hand Tractor PTO
Centrifugal Rotary Flowing Well	Windmill Other (specify): _____
Other (specify): _____	Horse Power Rating of Motor: <u>3</u>
Date Pump Installed: <u>10-8-09</u>	Setting Depth: <u>110</u> feet
Rated Pump Capacity: <u>33</u> Gallons Per Minute	Number of Stages: <u>11</u>

Pump Test Data	Method of Measuring Water Level Circle one
Date Well Tested: <u>10-8-09</u>	Air Line Electric Measuring Line <input checked="" type="radio"/> Steel Tape
Static Water Level (A): <u>70</u> Feet Below Land Surface	Other (specify): _____
Pumping Water Level (B): <u>110</u> Feet Below Land Surface	For flowing well, measured shut in head: _____ feet
Drawdown [(B) - (A)]: <u>80</u> Feet Below Land Surface	Well yielded <u>40</u> GPM with a drawdown of
Test Pumping Rate: <u>40</u> Gallons Per Minute	<u>10</u> feet after <u>4</u> hours of pumping
Duration of Pump Test (minimum 4 hours): <u>4</u> hours	

I HEREBY CERTIFY that the above statements are true to the best of my knowledge.

JAMES WELLS 0-586 James Wells
 Print Name of Pump Installer and License No. (if applicable) Signature of Pump Installer