

Simpson
Q 2600
8-23-76

MISSISSIPPI
 BOARD OF WATER COMMISSIONERS
 416 North State Street
 Jackson, Mississippi 39201

WATER WELL DRILLERS LOG

8-23 ¹³⁰ 76 W.K. Barnes Water Well Simpson
 date well completed firm name county well located

LANDOWNER: <u>Tommie Stuffs</u>	description of formations encountered	from	to
		<u>mt. olive</u>	<u>0</u>
	<u>Red clay</u>	<u>6</u>	<u>17</u>
	<u>Red sand</u>	<u>17</u>	<u>67</u>
	<u>Gravel</u>	<u>67</u>	<u>131</u>
	<u>yellow clay</u>	<u>131</u>	<u>142</u>
	<u>Gravel & Sand</u>		

WELL LOCATION:
 sec. 35 T. 10 N. R. 17 E.
2 miles (distance) W (direction) of mt. olive (nearest town)

WELL PURPOSE: Home
 (home, irrigation, municipal, industrial)

- WELL COMPLETION DATA:
- (1) diameter (inches) 2
 - (2) total depth (feet) 142
 - (3) static water level (feet) 91 below above top of ground.
 - (4) casing Galv. (material) 137 (depth)
 - 2" (size) if telescope see back.
 - (5) screen 5' (length) (depth to top)
 - 08 (size) Stainless S. (material)
 - (6) pump 1 (HP) 8 (yield gpm)
 - elec. (type power)
 - (7) electric log no (yes or no)
 - (organization running log)
 - (8) how well bottom plugged wash hole


DRILLERS REMARKS:

RECEIVED
 SEP - 7 1976

MISS. RD. OF WATER COMMISSIONERS

If well telescopes please sketch and show depths.

GROUND LEVEL

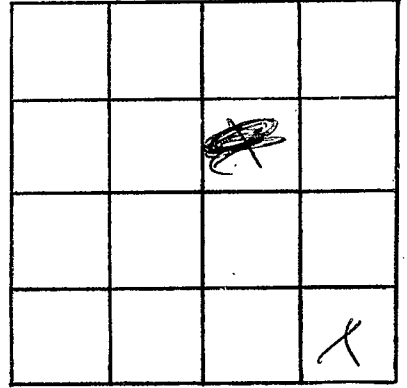

SECTION 35

Please indicate well location X.

ADDITIONAL INFORMATION

If more than one screen,
show locations of each on sketch.