

**SIMPSON**  
 1/3/78

MISSISSIPPI  
 BOARD OF WATER COMMISSIONERS  
 416 North State Street  
 Jackson, Mississippi 39201

WATER WELL DRILLERS LOG

Jan 3 1978 *Tom Griffith Plumbing Simpson*  
 date well completed firm name well county well located

LANDOWNER:

*M. James E. Smith*  
 Rt. 2 Box 337 Magee Miss  
 (mailing address)

description of formations encountered

from to

<i>Top Soil</i>	0	1
<i>Clay</i>	1	27
<i>Chalk</i>	27	63
<i>Sand</i>	63	100

WELL LOCATION:

sec 20 T. 10 N R. 17 E  
2 miles S of Magee  
 (distance) (direction) (nearest town)

WELL PURPOSE: Home  
 (home, irrigation, municipal, industrial)

WELL COMPLETION DATA:

- (1) diameter (inches) 2"
- (2) total depth (feet) 100 ft.
- (3) static water level (feet) 80 ft. below top of ground
- (4) casing Plastic 90 ft.  
 (material) (depth)  
2" (size) if telescope see back.
- (5) screen 10 ft. 90 ft.  
 (length) (depth to top)  
Plastic (material)
- (6) pump 1 Hp 7  
 (HP) (yield gpm)  
Elec (type power)
- (7) electric log no  
 (yes or no)

(organization running log)

(8) how well bottom plugged B.W. Valve


DRILLERS REMARKS:

RECEIVED  
 MAR 31 1978

MISS. BD. OF WATER COMMISSIONERS

If well telescopes please sketch and show depths.

GROUND LEVEL

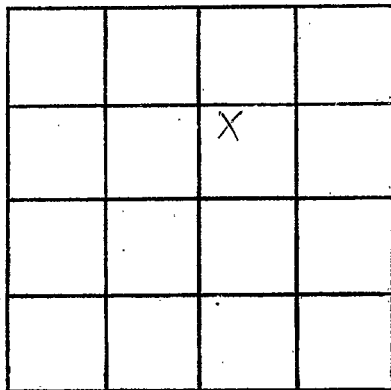

SECTION 20

Please indicate well location X.

ADDITIONAL INFORMATION

If more than one screen,  
show locations of each on sketch.