

Simpson
Q 2002
7-2-81

MISSISSIPPI
BOARD OF WATER COMMISSIONERS
416 North State Street
Jackson, Mississippi 39201

WATER WELL DRILLERS LOG

July 2 1981 81 Royl West Drlg Simpson
date well completed firm name county well located

LANDOWNER:	description of formations encountered	from	to
Drinson Hand MAGEE (mailing address)			
	SAND	15	20
	SANDY CLAY	20	30
	GRAVEL	30	38
	CLAY	38	70
	SAND	70	104
	CLAY	104	106
	COARSE SAND	106	130
WELL LOCATION: sec. 6 T. 10N R. 17E S W 1/2 miles SW of Magee (distance) (direction) (nearest town)			
WELL PURPOSE: Irrigation (home, irrigation, municipal, industrial)			
WELL COMPLETION DATA:			
(1) diameter (inches) 4"			
(2) total depth (feet) 130'			
(3) static water level (feet) 40' below top of ground.			
(4) casing PVC 120' (material) (depth)			
(size) If telescope see back.			
(5) screen 10' 120' (length) (depth to top)			
4" PVC (size) (material)			
(6) pump 1/2 16 (HP) (yield gpm)			
REA (type power)			
(7) electric log NO (yes or no)			
(organization running log)			
(8) how well bottom plugged WASH VALVE			
DRILLERS REMARKS:			


DEPT. OF NATURAL RESOURCES
BUREAU OF LAND & WATER RESOURCES

JUL 22 1981

RECEIVED

If well telescopes please sketch and show depths.

GROUND LEVEL

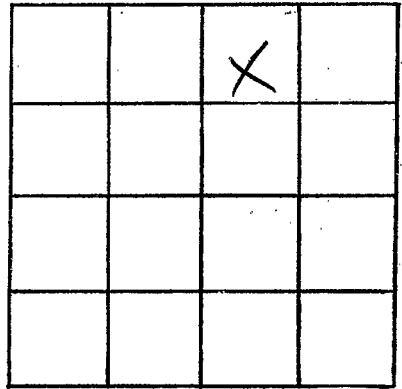

SECTION 6

Please indicate well location X.

ADDITIONAL INFORMATION

If more than one screen, show locations of each on sketch.