

MISSISSIPPI DEPARTMENT OF NATURAL RESOURCES

Bureau of Land and Water Resources

Southport Mall

P.O. Box 10631

Jackson, Mississippi 39209

WATER WELL DRILLERS LOG

TOM GRIFFITH

PLUMBING & WELL SERVICE, INC.

320 MATYSON AVE.

COLUMBIA, MS 39429

Simpson  
county well located

Simpson  
Q  
2004

8-3-83 19  
date well completed

LANDOWNER: W.H. Maddox  
Rt. 4, Box 124  
Mt. Olive  
Mager, MS 39119  
(mailing address)

description of formations encountered	from	to
<u>Chalk</u>	<u>0</u>	<u>15</u>
<u>Sand &amp; Pea Gravel</u>	<u>15'</u>	<u>100'</u>

WELL LOCATION:  
sec. 10 T. 10 N. R. 17 E.  
S. W.  
4 miles SE of Mager  
(distance) (direction) (nearest town)

WELL PURPOSE: home  
(home, irrigation, municipal, industrial)

- WELL COMPLETION DATA:
- (1) diameter (inches) 4"
  - (2) total depth (feet) 100
  - (3) static water level (feet) 48 below above top of ground.
  - (4) casing PVC, 90'  
(material) (depth)  
N/A if telescope see back.  
(size)
  - (5) screen 10', 90'  
(length) (depth to top)  
4", PVC  
(size) (material)
  - (6) pump 1 1/2, 10  
(HP) (yield gpm)  
elec.  
(type power)
  - (7) electric log NO.  
(yes or no)  
N/A  
(organization running log)
  - (8) how well bottom plugged BCWV

DRILLERS REMARKS:


DEPT. OF NATURAL RESOURCES  
BUREAU OF LAND & WATER RESOURCES

FEB 16 1984

RECEIVED

If well telescopes please sketch and show depths.

GROUND LEVEL

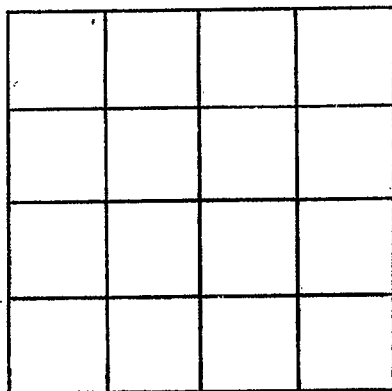

SECTION \_\_\_\_\_

Please indicate well location X.

ADDITIONAL INFORMATION

If more than one screen, show locations of each on sketch.