

**MISSISSIPPI DEPARTMENT OF NATURAL RESOURCES**

Bureau of Land and Water Resources

P.O. Box 10631  
Jackson, Mississippi 39209  
**WATER WELL DRILLERS LOG**

COUNTY WELL LOCATED <u>Simpson</u>	
WELL NUMBER <u>9</u>	CODED
DATE WELL COMPLETED <u>2000 6-27-88</u>	

PERMIT NUMBER
NAME OF DRILLING FIRM <u>Roy V. West Dalg</u>

NAME & MAILING ADDRESS OF LANDOWNER <u>Jack Pace</u> <u>Magee MS</u>			
WELL LOCATION: SEC	TOWNSHIP	RANGE	
<u>21</u>	<u>10 S</u>	<u>17 W</u>	
DISTANCE	DIRECTION	NEAREST TOWN	
<u>6</u> Miles	<u>S</u>	of <u>Magee</u>	
OTHER LANDMARK			
WELL PURPOSE: Home <input checked="" type="checkbox"/> Irrigation, Municipal, Industrial, Fish Pond, etc.			

PUMP DATA		
PUMP TYPE (Circle One): <input checked="" type="checkbox"/> Submersible     Turbine,     Jet     Flowing Well, Other (Describe) _____		
POWER TYPE (Circle One): <input checked="" type="checkbox"/> Electric     Tractor,     Diesel,     Gasoline,     Butane, Other (Describe) _____		
Pump Capacity (GPM)	No. of Stages	Setting Depth
<u>100</u>		_____ FT.
PUMP TEST		
Well yielded <u>100</u> GPM with a drawdown of <u>15</u> ft. after <u>2</u> hours of pumping		

WELL DATA		
Well Depth <u>125'</u>	Casing Diameter (In.) <u>4"</u>	Casing Length (Ft.) <u>105'</u>
Type of Casing <u>PVC</u>	Hole Depth <u>125'</u>	Depth to Static Water Level <u>415'</u>
TYPE OF COMPLETION: (Circle One or More): <input checked="" type="checkbox"/> Gravel Packed, <input type="checkbox"/> Underreamed, <input type="checkbox"/> Telescoped, <input checked="" type="checkbox"/> Natural Development, <input type="checkbox"/> Open Hole, <input type="checkbox"/> Other		
Top of Lap Pipe or Reduction in Casing		
FEET     IF TELESCOPED OR MORE THAN ONE SCREEN: USE BACK PAGE		

LOG DATA	
TYPE OF LOG RUN (Circle One): Electric, Gamma Ray, Density, Sonic, <input checked="" type="checkbox"/> No Log Run, Neutron, Other (Describe) _____	
Name of Organization Running Log	


SCREEN DATA		
Diameter - Inches <u>4"</u>	Length - Feet <u>20'</u>	Slot Size - Inches <u>.010</u>
Screen Type <u>PVC SLOTTED</u>	Depth to Bottom - Feet <u>125'</u>	

GEOLOGIC DATA (Office Use Only)			
Surface Elev.	Geologic Unit	Unit Thickness	Depth to Top
Subs. SWL	Date	Analysis	Aquifer Test
<b>RECEIVED</b>			
Driller's Remarks			
JAN 11 1989			
Department of Natural Resources Bureau of Land & Water Resources			

DESCRIPTION OF FORMATIONS ENCOUNTERED	FROM	TO	FORMATIONS (Continued)	FROM	TO
<u>Red CLAY</u>	<u>0</u>	<u>2</u>			
<u>CLAY Gravel</u>	<u>2</u>	<u>46</u>			
<u>GRAVEL</u>	<u>46</u>	<u>58</u>			
<u>SAND</u>	<u>58</u>	<u>125'</u>			
IF MORE SPACE IS NEEDED, USE BACK					

If well telescopes please sketch and show depths.

GROUND LEVEL

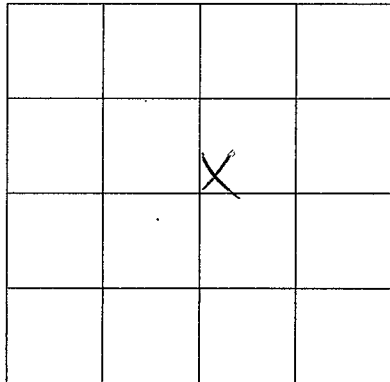

SECTION 21

Please indicate well location X.

ADDITIONAL INFORMATION

If more than one screen,  
show location of each on sketch.