

**MISSISSIPPI DEPARTMENT OF ENVIRONMENTAL QUALITY**

Office of Land and Water Resources

P. O. Box 10631  
Jackson, MS 39289-0631  
**WATER WELL DRILLERS LOG**

COUNTY WELL LOCATED <u>Madison</u>	
WELL NUMBER <u>Q-2013</u>	CODED
DATE WELL COMPLETED <u>7-11-00</u>	

PERMIT NUMBER
NAME OF DRILLING FIRM <u>Roy U West</u>

NAME & MAILING ADDRESS OF LANDOWNER <u>Danny Craft</u>			
<u>155 Bronson Dr.</u>			
<u>Magee MS 39111</u>			
WELL LOCATION	SEC	TOWNSHIP	RANGE
	<u>24</u>	<u>10 N</u>	<u>17 E</u>
DISTANCE	DIRECTION	NEAREST TOWN	
<u>6</u> Miles	<u>SE</u>	of <u>Magee</u>	
OTHER LANDMARK			
WELL PURPOSE Home, Irrigation, Municipal, Industrial, Fish Pond, etc. <u>Poultry Farm</u>			

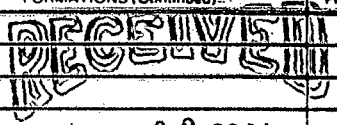
PUMP DATA		
PUMP TYPE (Circle One): <input checked="" type="radio"/> Submersible <input type="radio"/> Turbine <input type="radio"/> Jet <input type="radio"/> Flowing Well. Other (Describe) _____		
POWER TYPE (Circle One): <input checked="" type="radio"/> Electric <input type="radio"/> Tractor <input type="radio"/> Diesel <input type="radio"/> Gasoline <input type="radio"/> Butane. Other (Describe) _____ H/P <u>1</u>		
Pump Capacity (GPM): <u>20</u>	No of Stages	Setting Depth <u>60</u> FT.
PUMP TEST		
Well yielded _____ GPM with a drawdown of _____ ft. after _____ hours of pumping		

WELL DATA		
Well Depth <u>247</u>	Casing Diameter (In) <u>4</u>	Casing Length (Ft) <u>237</u>
Type of Casing <u>Pvc</u>	Hole Depth <u>247</u>	Depth to Static Water Level <u>18</u>
TYPE OF COMPLETION (Circle One or More): <input checked="" type="checkbox"/> Gravel Packed <input type="checkbox"/> Underreamed <input type="checkbox"/> Telescoped <input checked="" type="checkbox"/> Natural Development <input type="checkbox"/> Open Hole <input type="checkbox"/> Other		
WELL GROUTED TO A DEPTH OF <u>10</u> FEET Type Grout (circle one): <input checked="" type="radio"/> Cement <input type="radio"/> Bentonite, or Mix		

LOG DATA	
TYPE OF LOG RUN (Circle One): <input type="radio"/> Electric <input type="radio"/> Gamma-Ray <input type="radio"/> Density <input type="radio"/> Sonic <input type="radio"/> Neutron <input checked="" type="radio"/> No Log Run Other (Describe) _____	
Name of Organization Running Log	

SCREEN DATA		
Diameter - Inches <u>4</u>	Length - Feet <u>10</u>	Slot Size - Inches <u>.010</u>
Screen Type <u>Pvc</u>	Depth to Bottom - Feet <u>247</u>	

GEOLOGIC DATA (Office Use Only)			
Surface Elev	Geologic Unit	Unit Thickness	Depth to Top
Subs SWL	Date	Analysis	Aquifer Test
Driller's Remarks			
Top of Lap Pipe or Reduction in Casing			
FEET		IF TELESCOPED OR MORE THAN ONE SCREEN: USE BACK PAGE	

DESCRIPTION OF FORMATIONS ENCOUNTERED	FROM	TO	FORMATIONS (Continued)	FROM	TO
<u>SANDY CLAY</u>	<u>0</u>	<u>18</u>			
<u>CLAY GRAVEL</u>	<u>18</u>	<u>43</u>			
<u>CLAY</u>	<u>43</u>	<u>228</u>			
<u>SAND</u>	<u>228</u>	<u>247</u>			
			FEB 02 2001		
			Dept. of Environmental Quality Office of Land & Water Resources		
			IF MORE SPACE IS NEEDED, USE BACK		

1948

1949