

Smith  
 A1  
 10-17-66  
 M.G.S.  
 Oct. 17

MISSISSIPPI  
 BOARD OF WATER COMMISSIONERS  
 416 North State Street  
 Jackson, Mississippi 39201

CODED

WATER WELL DRILLERS LOG

1966 LeRiver Drilling Service, Inc. Smith  
 date well completed firm name county well located

LANDOWNER: Polkville Water Ass'n. (mailing address)	description of formations encountered	from	to
	Top Soil	0	2
	CLAY	2	44
	SAND	44	70
	CLAY	70	510
	SAND	510	527
	CLAY	527	580
	SAND	580	623
WELL LOCATION: sec. 9 T. 4N R. 6E S W 2 miles N of Polkville (distance) (direction) (nearest town)			
WELL PURPOSE: MUNICIPAL (home, irrigation, municipal, industrial)			
WELL COMPLETION DATA:			
(1) diameter (inches) 8.5"			
(2) total depth (feet) 650'			
(3) static water level (feet) 185' below top of ground			
(4) casing (material) Steel (depth) 600'			
8.5" (size) if telescope see back.			
(5) screen (length) 40' (depth to top) 610'			
6.5" (size) SS (material)			
(6) pump (HP) 15 (yield gpm) 150			
Elec (type power)			
(7) electric log Yes (yes or no)			
MSE 6-17-66 (organization running log)			
(8) how well bottom plugged Back Wash Jaw			

CODED


APR 15 1967

MISSISSIPPI BOARD OF WATER COMMISSIONERS

DRILLERS REMARKS:

If well telescopes please sketch and show depths.

GROUND LEVEL

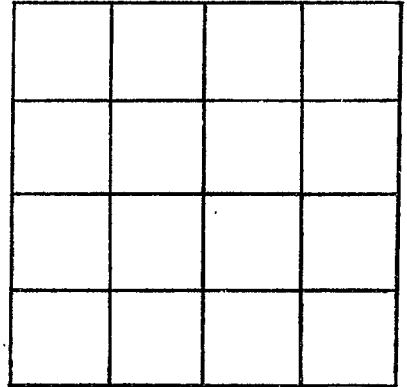

SECTION 9

Please indicate well location X.

ADDITIONAL INFORMATION

If more than one screen, show locations of each on sketch.