

CODED

CODED

CODED

Smith
A 2
7-66
E-109

MISSISSIPPI
BOARD OF WATER COMMISSIONERS
416 North State Street
Jackson, Mississippi 39201

WATER WELL DRILLERS LOG

7/8 1966 date well completed
Water Well Ser. Co. Rankin firm name
county well located

LANDOWNER: William Bradshaw
H -
Pickett, Miss.
(mailing address)

description of formations encountered	from	to
	<u>Sand</u>	<u>0</u>
<u>Blue clay</u>	<u>92</u>	<u>656</u>
<u>sand</u>	<u>656</u>	<u>702</u>
<u>clay</u>	<u>702</u>	<u>710</u>

WELL LOCATION: SE, NW
sec. 31 T. 4 N. R. 6 E
S W
7 miles N of Pickett
(distance) (direction) (nearest town)

WELL PURPOSE: Home
(home, irrigation, municipal, industrial)

WELL COMPLETION DATA:

- (1) diameter (inches) 4 1/2
- (2) total depth (feet) 710
- (3) static water level (feet) 100 ^{below} _{above} top of ground.
- (4) casing B. Iron 315
(material) (depth)
4" If telescope see back.
(size)
- (5) screen 15 685
(length) (depth to top)
2" S. Steel
(size) (material)
- (6) pump 1-Sub 20
(HP) (yield gpm)
Electric
(type power)
- (7) electric log yes
(yes or no)
Miss. Des. Ser.
(organization running log)
- (8) how well bottom plugged _____

DRILLERS REMARKS:

CODED

CODED


CODED

CODED

JUL - 8 1968
MISS. BOARD OF
WATER COMMISSIONERS

If well telescopes please sketch and show depths.

GROUND LEVEL

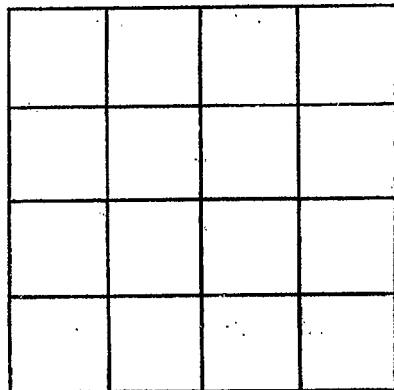

SECTION _____

Please indicate well location X.

ADDITIONAL INFORMATION

If more than one screen, show locations of each on sketch.