

SMITH MISSISSIPPI BOARD OF WATER COMMISSIONERS

4 A5

3-4-61

WATER WELL DRILLERS LOG

T
A-302

Date: MAR. 4, 1961, Driller: W.G. Butler County Smith

(Name)

Schley and

(1) Owner of Land: Howard Purvis

(Name)

Polkville Miss

(Address)

(2) Location: 5 1/2 SW 1/4, Sec. 20 T4R6

17 miles South, of Morton

(distance)

(direction)

(Nearest Town)

(3) Topography: (Hilly)

(Flat)

(Level)

(4) Purpose of Well: Domestic

(Domestic Irrigation
Municipal, Industrial, Other)

Description & Color of Materials Sand, Clay, Red Clay, Shell, etc.	Thick- ness Feet	Depth Feet
<u>Clay</u>	<u>17</u>	<u>2</u>
<u>Chalk</u>	<u>27</u>	<u>20</u>
<u>sand & Chalk</u>	<u>20</u>	<u>30</u>
<u>Blue Chalk</u>	<u>30</u>	<u>90</u>
<u>Blue Sand & Chalk</u>	<u>90</u>	<u>150</u>
<u>Chalk + Lignite</u>	<u>100</u>	<u>110</u>
<u>Fine Salt + Pepper Sand</u>	<u>110</u>	<u>120</u>

Information upon completion of well:

(1) Diameter 2" inches.

(2) Total Depth 120 feet.

(3) Water Level 75 feet below top of ground.

(4) Cased to 115, Size 2"

(5) Screen: Size 2", Length 6'


(6) Were any formations sealed against pollution?

yes, no.

If YES depth of formation _____

Why _____

Drillers Remarks: _____

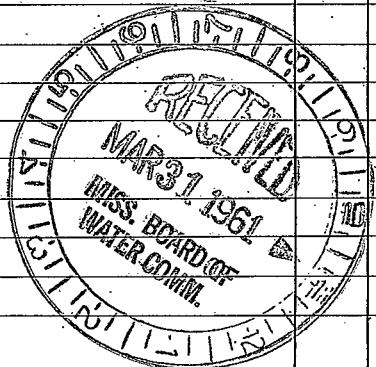

(Use Back Side)

Well No.

1870
1871
1872
1891
1892
1893