

SMITH MISSISS.

4 A6
9-19-61

WATER WELL DRILLERS LOG

T A 303

Date: Sept. 19, 1961, Driller: W. G. Butler County SMITH
(Name)

(1) Owner of Land: Henry Mayo
(Name)
Palkville, Miss
(Address)

(2) Location: $\frac{1}{4}$, NE $\frac{1}{4}$, Sec. 17 T4R10
1 miles South, of Palkville
(distance) (direction) (Nearest Town)

(3) Topography: (Hilly) (Flat) (Level)


(4) Purpose of Well: Domestic
(Domestic Irrigation, Municipal, Industrial, Other)

Information upon completion of well:

- (1) Diameter 2" inches.
- (2) Total Depth 111 feet.
- (3) Water Level 25 feet below top of ground.
- (4) Cased to 105, Size 2"
- (5) Screen: Size 2", Length _____
- (6) Were any formations sealed against pollution?
_____ yes, no.

If YES depth of formation _____
Why _____
Drillers Remarks: _____

Description & Color of Materials Sand, Clay, Red Clay, Shell, etc.	Thick- ness Feet	Depth Feet
Clay	1-10	
sand	10-40	
sand + chalk	40-50	
Rock + chalk	50-60	
sand + chalk	60-70	
sand	70-111	

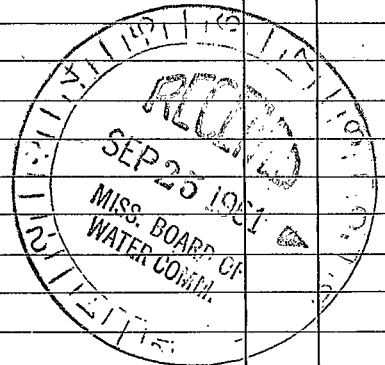

Well No.

(Use Back Side)

Retain this copy for your office files.

