

SMITH

WATER WELL DRILLERS LOG

A T

Date: 1-25-62, 1962, Driller: W. H. Butler County Smith

(Name)

(1) Owner of Land: Thomas Phillip
(Name)
Polkville, Miss
(Address)

Description & Color of Materials
Sand, Clay, Red Clay, Shell, etc.
Clay
Red sand clay
sand

Thick-ness Feet
Depth Feet
0-8
8-25
25-37

(2) Location: 1/4, 1/4, Sec. 9 T4R6,
1/2 miles East of Polkville,
(distance) (direction) (Nearest Town)

(3) Topography: (Hilly) (Flat) (Level)


(4) Purpose of Well: (Domestic Irrigation)
 (Municipal, Industrial, Other)

Information upon completion of well:

- (1) Diameter 2 inches.
- (2) Total Depth 37 feet.
- (3) Water Level 2.5 feet below top of ground.
- (4) Cased to 32', Size 2"
- (5) Screen: Size 2", Length 5'
- (6) Were any formations sealed against pollution?
yes, no.

If YES depth of formation _____
Why _____

Drillers Remarks: _____

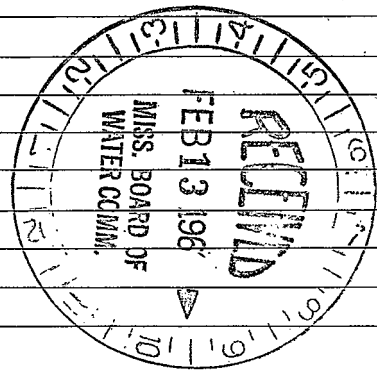

(Use Back Side)

Well No.

