

5 AB
5-18-62

WATER WELL DRILLERS LOG


Date: May 18, 1962, Driller: W. G. Butler County Smith
(Name)

(1) Owner of Land:	Description & Color of Materials Sand, Clay, Red Clay, Shell, etc.	Thick- ness Feet	Depth Feet
<u>George (Bob) Farmer</u> (Name) <u>Morton-Star Rt. Miss</u> (Address)	<u>0.1 m</u> <u>Red sand</u>	<u>1-5</u> <u>5-20</u>	
(2) Location: <u>1/4</u> , <u>1/4</u> , Sec. <u>4</u> <u>1</u> miles <u>North</u> of <u>Polkville</u> (distance) (direction) (Nearest Town)	<u>Sand</u> <u>Chalk</u> <u>Sand</u> <u>Chalk</u>	<u>20-36</u> <u>36-40</u> <u>40-47</u> <u>47-50</u>	<u>56</u> <u>40</u> <u>47</u> <u>50</u>
(3) Topography: <u>✓</u> (Hilly) (Flat) (Level)			
(4) Purpose of Well: <u>Domestic</u> (Domestic Irrigation Municipal, Industrial, Other)			

Information upon completion of well:

- (1) Diameter 2 inches.
- (2) Total Depth 50 feet.
- (3) Water Level 42 feet below top of ground.
- (4) Cased to 42, Size 2"
- (5) Screen: Size 2", Length 5"
- (6) Were any formations sealed against pollution?
_____ yes, _____ no.

If YES depth of formation _____
Why _____
Drillers Remarks: _____

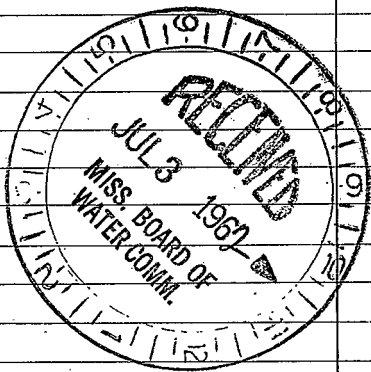

(Use Back Side)

Well No.

