

S A14
11-6-63

T

WATER WELL DRILLERS LOG

Date: Nov. 6, 1963, Driller: W. G. Butler County Smith
(Name)

(1) Owner of Land:	Description & Color of Materials Sand, Clay, Red Clay, Shell, etc.	Thick- ness Feet	Depth Feet
<u>Polkville Pentecostal</u> (Name)	<u>TOP SOIL</u>	<u>1-2</u>	<u>2</u>
<u>Church, Morton, Miss</u> (Address)	<u>Chalk</u>	<u>2</u>	<u>10</u>
(2) Location: <u>1/4, 1/4, Sec. 9 T4 R6E</u> <u>2 miles East of Polkville</u> (distance) (direction) (Nearest Town)	<u>Blue chalk</u>	<u>10</u>	<u>20</u>
	<u>Blue chalk + limestone</u>	<u>20</u>	<u>25</u>
	<u>Fine sand</u>	<u>5</u>	<u>30</u>
(3) Topography: <input checked="" type="checkbox"/> (Hilly) <input type="checkbox"/> (Flat) <input type="checkbox"/> (Level)			
(4) Purpose of Well: <u>Domestic</u> (Domestic Irrigation Municipal, Industrial, Other)			


Information upon completion of well:

- (1) Diameter 2 inches.
- (2) Total Depth 30 feet.
- (3) Water Level _____ feet below top of ground.
- (4) Cased to 32, Size 2
- (5) Screen: Size 1 1/4, Length 5'
- (6) Were any formations sealed against pollution?
_____ yes, _____ no.

If YES, depth of formation _____

Why _____

Drillers Remarks: _____

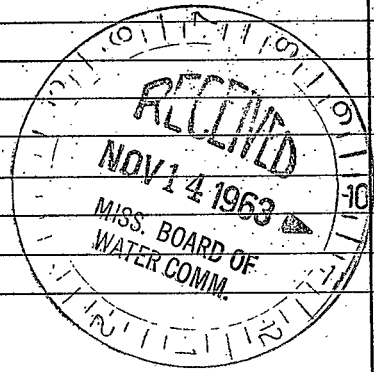

(Use Back Side)

Well No.

1948

...

...

