

5 A15  
6-13-64

WATER WELL DRILLERS LOG

Date: JUNE 13, 1964, Driller: W. B. Butler County Smith  
(Name)


(1) Owner of Land: Mrs. D.W. Polk.  
(Name)  
MORTON, Rt 4 - MISS  
(Address)  
(2) Location: 1/4, 1/4, Sec. 21 T4 R6 E  
2 miles S.E. of Polkville  
(distance) (direction) (Nearest Town)  
(3) Topography:  (Hilly)  (Flat)  (Level)  
(4) Purpose of Well: Domestic  
(Domestic Irrigation  
Municipal, Industrial, Other)

Description & Color of Materials Sand, Clay, Red Clay, Shell, etc.	Thick- ness Feet	Depth Feet
Red Clay	1-5	
Chalk	5-20	
Chalk + Rock	20-30	
Sand + Shell	30-34	
Rock + Chalk	34-40	
Chalk	40-45	
Rock	45-50	
Blue Chalk	50-65	
Sand + Chalk	65-70	
Chalk + Fine Sand	70-80	
Chalk + Lignite	80-110	
Chalk + Sand	110-120	
Sand	120-140	

Information upon completion of well:

(1) Diameter 2 inches.  
(2) Total Depth 137 feet.  
(3) Water Level 60 feet below top of ground.  
(4) Cased to 126', Size 2"  
(5) Screen: Size 2", Length 10'  
(6) Were any formations sealed against pollution?  
no.

If YES depth of formation \_\_\_\_\_  
Why \_\_\_\_\_  
Drillers Remarks: \_\_\_\_\_

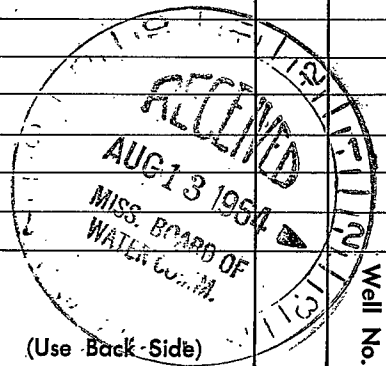

(Use Back Side)

