

WATER WELL DRILLERS LOG

S A17  
8-64

Date: Aug -, 19 64 Driller: W. H. Butler County Smith  
(Name)

(1) Owner of Land: Robert Seary  
(Name)  
Morton, Miss RT4  
(Address)

(2) Location: 1/4, 1/4, Sec. 15 T4 R6E  
2 miles E of Parkville  
(distance) (direction) (Nearest Town)

(3) Topography:  (Hilly)  (Flat)  (Level)

(4) Purpose of Well: Domestic  
(Domestic Irrigation  
Municipal, Industrial, Other)

Description & Color of Materials Sand, Clay, Red Clay, Shell, etc.	Thick- ness Feet	Depth Feet
Red Clay	1-10	
Chalk + red sand	10-20	
Chalk	20-30	
sand + chalk	30-40	
Chalk	40-50	
Chalk + limestone	50-60	
Chalk	60-68	
fine sand	68-70	
Chalk + limestone	70-77	
sand	77-80	
Chalk + sand	80-90	

Information upon completion of well:

(1) Diameter 2 inches.

(2) Total Depth 90 feet.

(3) Water Level: 70 feet below top of ground.


(4) Cased to 85', Size 2"

(5) Screen: Size 2", Length 5'

(6) Were any formations sealed against pollution?  
no

If YES depth of formation \_\_\_\_\_  
Why \_\_\_\_\_

Drillers Remarks: \_\_\_\_\_

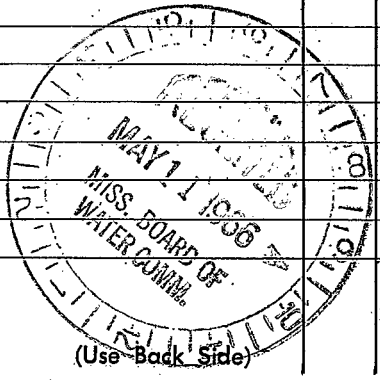

(Use Back Side)

Well No.

