

5 A 18
8-27-64

WATER WELL DRILLERS LOG

T

Date: Aug. 27, 1964, Driller: W. G. Butler County Smith

(Name)

(1) Owner of Land: W. W. Martin

(Name)

Brandon, Rt.

(Address)

(2) Location: 1/4, 1/4, Sec. 31 T4 R6E

 miles of
(distance) (direction) (Nearest Town)

(3) Topography: (Hilly) (Flat) (Level)

(4) Purpose of Well: Domestic

(Domestic Irrigation
Municipal, Industrial, Other)

Description & Color of Materials Sand, Clay, Red Clay, Shell, etc.	Thick- ness Feet	Depth Feet
Red clay	1-5	
Chalk	5-15	
Sand + Chalk	15-20	
Sand	20-80	
Sand + chalk	80-100	
Chalk + lignite	100-110	
Chalk	110-120	
Sand, chalk + lignite	120-130	
Chalk + lignite	130-135	
Sand	135-150	
Chalk	150-160	
Lignite + sand	160-170	
Sand	170-190	

Information upon completion of well:

(1) Diameter 2 inches.

(2) Total Depth 190 feet.

(3) Water Level feet below top of ground.

(4) Cased to 175, Size 2"

(5) Screen: Size 2", Length 10'


(6) Were any formations sealed against pollution?

 yes, no.

If YES depth of formation

Why

Drillers Remarks:

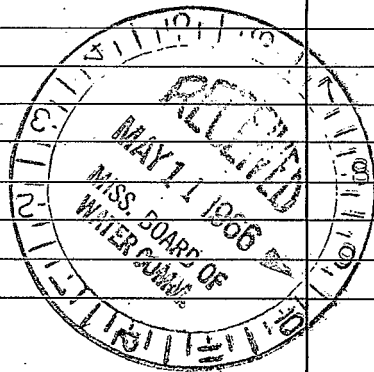

(Use Back Side)

Well No.

1910 - 1911 - 1912 - 1913 - 1914 - 1915

1916 - 1917 - 1918 - 1919 - 1920

1921 - 1922 - 1923 - 1924 - 1925
1926 - 1927 - 1928 - 1929 - 1930
1931 - 1932 - 1933 - 1934 - 1935
1936 - 1937 - 1938 - 1939 - 1940
1941 - 1942 - 1943 - 1944 - 1945
1946 - 1947 - 1948 - 1949 - 1950
1951 - 1952 - 1953 - 1954 - 1955
1956 - 1957 - 1958 - 1959 - 1960

1961 - 1962 - 1963 - 1964 - 1965

1966 - 1967 - 1968 - 1969 - 1970

1971 - 1972 - 1973 - 1974 - 1975
1976 - 1977 - 1978 - 1979 - 1980

1981 - 1982 - 1983 - 1984 - 1985
1986 - 1987 - 1988 - 1989 - 1990
1991 - 1992 - 1993 - 1994 - 1995
1996 - 1997 - 1998 - 1999 - 2000