

A20
1-4-66

WATER WELL DRILLERS LOG


Date: Jan 4, 1966, Driller: W. G. Butler County Smith
(Name)

(1) Owner of Land:	Description & Color of Materials Sand, Clay, Red Clay, Shell, etc.	Thick- ness Feet	Depth Feet
Melvin Bradshaw (Name) Milton Pt. 4 - (Address)	Red Sand	1	10
(2) Location: 1/4, 1/4, Sec. 17 T4R6E in Palmyra miles (distance) (direction) (Nearest Town)	Red sand + chalk	12	20
(3) Topography: / (Hilly) (Flat) (Level)	Sand + chalk	20	50
(4) Purpose of Well: Domestic (Domestic Irrigation Municipal, Industrial, Other)	Sand	20	90

Information upon completion of well:

- (1) Diameter 2 inches.
- (2) Total Depth 92' feet.
- (3) Water Level _____ feet below top of ground.
- (4) Cased to 63, Size 2"
- (5) Screen: Size 4", Length 10'
- (6) Were any formations sealed against pollution?
_____ yes, _____ no.

If YES depth of formation _____
Why _____
Drillers Remarks: _____

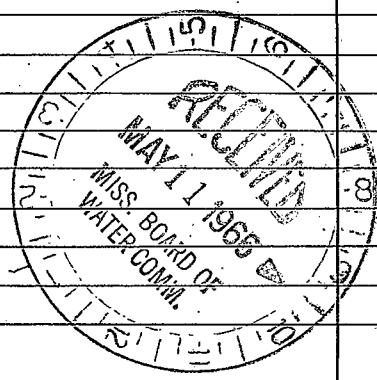

(Use Back Side)

Well No.

Handwritten text, possibly a signature or name, located in the upper left quadrant of the page. The text is faint and difficult to decipher.