

WATER WELL DRILLERS LOG

Date: May 28, 1964, Driller: W. H. Butler County Smith
 (Name)

(1) Owner of Land: John Mounney
 (Name)
Morton, Rte. Miss
 (Address)

(2) Location: 1/4, 1/4, Sec. 20 T4N R6E
3 1/2 miles south of Palokine
 (distance) (direction) (Nearest Town)

(3) Topography: (Hilly) (Flat) (Level)


(4) Purpose of Well: Domestic
 (Domestic Irrigation
 Municipal, Industrial, Other)

Description & Color of Materials Sand, Clay, Red Clay, Shell, etc.	Thick- ness Feet	Depth Feet
Clay	1-5	
Sand	5-20	
Sand + chalk	20-30	
Chalk	30-40	
Chalk + Sand	40-50	
Chalk	50-55	
Fine sand + chalk	55-65	
Chalk + Sand	65-70	
Chalk	70-85	
Sand	85-90	
Fine blue sand	90-100	
Rockite fine sand	100-120	
Fine sandy chalk	120-130	
Sand	135-140	
Chalk + Sand	140-150	
Chalk	150-160	
Chalk + Sand	160-170	
Sand + chalk	170-180	
- Sand -	180-190	

Information upon completion of well:

- (1) Diameter 2 inches.
- (2) Total Depth 190 feet.
- (3) Water Level _____ feet below top of ground.
- (4) Cased to 182, Size 2"
- (5) Screen: Size 2", Length 6'
- (6) Were any formations sealed against pollution?
 _____ yes, no.

If YES depth of formation _____
 Why _____
 Drillers Remarks: _____

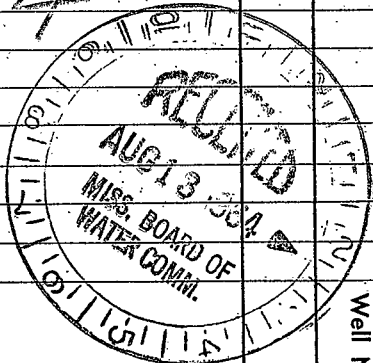

(Use Back Side)

[The page contains extremely faint and illegible text, likely bleed-through from the reverse side of the document. The text is scattered across the page and does not form any recognizable words or sentences.]