

SMITH
5 A22
2-13-64

MISSISSIPPI BOARD OF WATER COMMISSIONERS

WATER WELL DRILLERS LOG

T
Smith
Scott


Date: 2/13, 1964, Driller: Jack Dwyer, County: Scott
(Name)

(1) Owner of Land: Nelson Burns
(Name)
Rt of Manton, Miss
(Address)
(2) Location: 1/4, 1/4, Sec 21 T R
3 miles South of Belzoni
(distance) (direction) (Nearest Town)
(3) Topography: (Hilly) (Flat) (Level)
(4) Purpose of Well: Home
(Domestic Irrigation, Municipal, Industrial, Other)

Description & Color of Materials Sand, Clay, Red Clay, Shell, etc.	Thick- ness Feet	Depth Feet
Red clay	0	8
Sand + shells		22
Red sand		32
Clay		42
Clay + shells		52
Sand + shells		62
Sand		76
Clay		132
Clay + shells		142
Clay		166
fine sand + shells		182
fine sand		188

Information upon completion of well:

(1) Diameter 2 inches.
(2) Total Depth 188 feet.
(3) Water Level 84 feet below top of ground.
(4) Cased to 178, Size 2"
(5) Screen: Size 2", Length 10ft.
(6) Were any formations sealed against pollution?
yes, no.

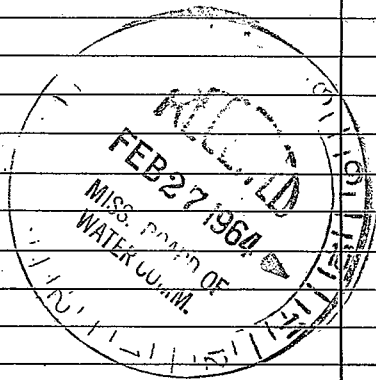

If YES depth of formation _____
Why _____
Drillers Remarks: _____

Well No.

(Use Back Side)

