

MISSISSIPPI BOARD OF WATER COMMISSIONERS

SMITH

6 A 29
1-2-65

WATER WELL DRILLERS LOG

Date: 1/2, 1965, Driller: Forest Dilling County Scott

(Name)

(1) Owner of Land: Mrs. G.W. Smith
(Name)
Rt. 1, Morton, Miss.
(Address)

(2) Location: 1/4, 1/4, Sec. 17 T. R.
of Forbes
(distance) (direction) (Nearest Town)

(3) Topography: (Hilly) (Flat) (Level)

(4) Purpose of Well: Chicken Farm
(Domestic Irrigation, Municipal, Industrial, Other)

Information upon completion of well:

(1) Diameter 2 inches.

(2) Total Depth 1060 feet.


(3) Water Level 210 feet below top of ground.

(4) Cased to 1050, Size 2"

(5) Screen: Size 2", Length 10ft

(6) Were any formations sealed against pollution?
yes, X no.

Description & Color of Materials Sand, Clay, Red Clay, Shell, etc.	Thick- ness Feet	Depth Feet
Red Clay		12
Blue Clay		72
Clay + Milky Sand		82
Clay		92
Clay + 1/4" 7. Sand		102
Clay		122
Clay + 1/4" 7. Sand		132
7. Sand + 1/4" Clay		142
Clay + 1/4" 7. Sand		152
Blue Clay		302
Shale		492
Shale + 1/4" Rock		502
Shale		512
Clay + 1/4" Sandy Shell		522
7. Sand + 1/4" Clay		532
Shale		542
Milky Sand + 1/4" Clay		562
7. Sand + 1/4" Clay		572
Shale		593
Shale + 1/4" 7. Sand		603
Shale		623
Shale + 1/4" 7. Sand		653
Soft Shale + 1/4" 7. Sand		673
Fine Sand		683
7. Sand + 1/4" Shale		693
Shale		823
Shale + Rock		890
Rock		897
Shale + Rock		907
Shale + 1/4" Sand		927
7. Sand + 1/4" Shale		947
Soft Shale		970
Fine Sand		1060

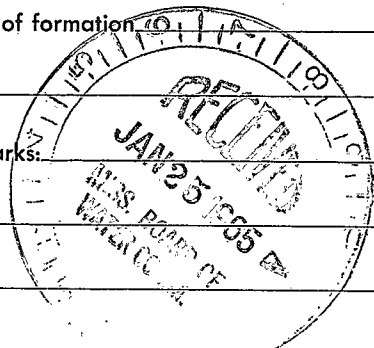

A5

(Use Back Side)

Well No.

