

MISSISSIPPI BOARD OF WATER COMMISSIONERS

SMITH
A26

WATER WELL DRILLERS LOG

Date: Oct. 6, 1962, Driller: W. G. Butler County Smith

(Name)

	Description & Color of Materials Sand, Clay, Red Clay, Shell, etc.	Thick- ness Feet	Depth Feet
(1) Owner of Land: <u>Lee Holley</u> (Name) <u>MAYTON, RT. 11, MISS</u> (Address)	Red Clay	1-	10
(2) Location: <u>1/4</u> , <u>1/4</u> , Sec. <u>28</u> T <u>14</u> R <u>6</u> E	Chalk	10-	20
_____ miles _____ of _____ (distance) (direction) (Nearest Town)	Rock	20-	40
(3) Topography: <input checked="" type="checkbox"/> (Hilly) <input type="checkbox"/> (Flat) <input type="checkbox"/> (Level)	Blue Chalk	40-	50
(4) Purpose of Well: <u>Domestic</u> (Domestic Irrigation Municipal, Industrial, Other)	Chalk + fine Sand	50-	60
	Chalk + limonite	60-	80
	Sand + Chalk	80-	100
	Sand	100-	110
	Chalk	110-	120
	Sand	120-	138
	Chalk + Sand	138-	160


Information upon completion of well:

- (1) Diameter 2 inches.
- (2) Total Depth 160 feet.
- (3) Water Level 75 feet below top of ground.
- (4) Cased to 126, Size 2"
- (5) Screen: Size 2", Length 10
- (6) Were any formations sealed against pollution?
_____ yes, _____ no.

If YES depth of formation _____

Why _____

Drillers Remarks: _____

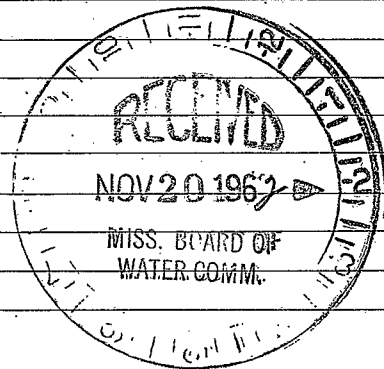

(Use Back Side)

Well No.

1910

1910
1911
1912
1913
1914
1915
1916
1917
1918
1919
1920

1910
1911
1912
1913
1914
1915
1916
1917
1918
1919
1920

1910
1911
1912
1913
1914
1915
1916
1917
1918
1919
1920