

SMITH
A27
7-8-61

MISSISSIPPI BOARD OF WATER COMMISSIONERS

WATER WELL DRILLERS LOG

Date: 7/7 & 7/8 1961, Driller: Johnnie Beasley County Smith
(Name)


(1) Owner of land: David Pace
(Name)
This well located about 15 miles South
of Morton.
(Address)
(2) Location: 1/4, 1/4, Sec. 20 T. 4 N. R. 6 E
15 miles South of Morton
(distance) (direction) (Nearest Town)
(3) Topography: x
(Hilly) (Flat) (Level)
(4) Purpose of Well: Domestic
(Domestic Irrigation
Municipal, Industrial, Other)

Description & Color of Materials Sand, Clay, Red Clay, Shell, etc.	Thick- ness Feet	Depth Feet
Clay & sand.		0 - 22
Blue clay.		22 - 135
Clay & stks. lime rock.		135 - 140
Blue clay.		140 - 420
Lime, sand & shell.		420 - 435
Shale.		435 - 452
Shale & stks. silt.		452 - 555
Shale & stks. sand.		555 - 576
Fine sand 7 Stks. shale.		576 - 596
Shale.		596 - 608
Shale & stks. sand.		608 - 618
Shale.		618 - 640
Fine sand.		640 - 650
Shale.		650 - 658
Sand. (10' Screen set here)		658 - 668
Shale.		668 - 691
Shale & stks. sand.		691 - 709
Sand. (5' Screen set here)		709 - 714

Information upon completion of well:

(1) Diameter 2 inches.
(2) Total Depth 714 feet.
(3) Water Level 150 feet below top of ground.
(4) Cased to 699', Size 2"
(5) Screen: Size 2", Length 15'
(6) Were any formations sealed against pollution?
x yes, no.

If YES depth of formation _____
Why _____
Drillers Remarks: Good well

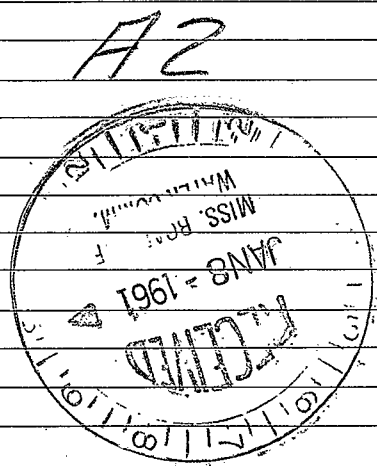

(Use Back Side)

Well No.

