

131

MISSISSIPPI BOARD OF WATER COMMISSIONERS 416 North State Street Jackson, Mississippi 39201

CODED

CODED

WATER WELL DRILLERS LOG

CODED

Smith A31 7-31-68

1968 date well completed Ernest Dilling Smith county well located

LANDOWNER: Gray Taylor Rt. 4 Marton, Miss (mailing address)

Table with 3 columns: description of formations encountered, from, to. Rows include Clay, Red Sand, Sand + Shale, Blue Clay, Shale, Sand + Shale, Sandy Shell, Sandy Shell + Clay, Soft Shale, Sand + Clay, Mfg Sand + Soft Shale, Shale, Sand + Shale, Fair Sand, Fine Sand.

WELL LOCATION: sec 2 T 4 N R 6 E 3 miles N of Falkville (distance) (direction) (nearest town)

WELL PURPOSE: Protection (home, irrigation, municipal, industrial)

WELL COMPLETION DATA:

- (1) diameter (inches) 2"
(2) total depth (feet) 590
(3) static water level (feet) 181 below top of ground
(4) casing 5" 5'75" (material) (depth)
(5) screen 2" 5'75" (length) (depth to top)
(6) pump 5 HP 15 (yield gpm)
(7) electric log No (yes or no)

(8) how well bottom plugged Blue

DRILLERS REMARKS:

JAN - 8 1969

MISS. BD. OF WATER COMM.


CODED

CODED

CODED

If well telescopes please sketch and show depths.

GROUND LEVEL

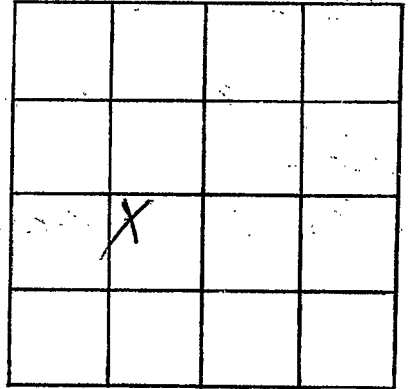

SECTION 2

Please indicate well location X.

ADDITIONAL INFORMATION

If more than one screen,
show locations of each on sketch.