

MISSISSIPPI
BOARD OF WATER COMMISSIONERS
416 North State Street
Jackson, Mississippi 39201

CODED

WATER WELL DRILLERS LOG

SMITH
A 33
7-6-70

July 6 1970 W. H. Butler Smith
date well completed firm name county well located

LANDOWNER:
L. C. Beatty
Palmville, Miss.
(mailing address)

WELL LOCATION:
sec. 1 T. 4 N R. 6 E
3 1/4 miles NE of Palmville
(distance) (direction) (nearest town)

WELL PURPOSE: Home
(home, irrigation, municipal, industrial)

WELL COMPLETION DATA:

(1) diameter (inches) 2"
(2) total depth (feet) 641'
(3) static water level (feet) _____ below above top of ground.
(4) casing galv., 621' (material) (depth)
2" if telescope see back. (size)
(5) screen 20', 621' (length) (depth to top)
2", SS (size) (material)
(6) pump Air Comp. (HP) (yield gpm)
Electric (type power)
(7) electric log No (yes or no)
(organization running log)
(8) how well bottom plugged 2" B.W.V.

description of formations encountered	from	to
CLAY	0	10
SAND & CLAY	10	32
CLAY	32	40
Shell & CLAY	40	60
CLAY	60	315
Rock	315	318
CLAY	318	347
CLAY, SAND & Shell	347	368
SAND - Shell	368	389
SAND & Lignite	389	452
SAND & CLAY	452	473
SAND	473	494
SAND & CLAY	494	515
SAND & Lignite	515	536
SAND	536	641

CODED


AUG 6 1970

DRILLERS REMARKS:

MISS. BD. OF WATER COMM.

If well telescopes please sketch and show depths.

GROUND LEVEL

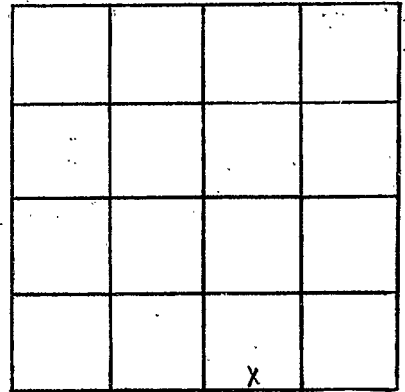

SECTION 1

Please indicate well location X.

ADDITIONAL INFORMATION

If more than one screen,
show locations of each on sketch.