

MISSISSIPPI  
BOARD OF WATER COMMISSIONERS  
416 North State Street  
Jackson, Mississippi 39201

**CODED**

WATER WELL DRILLERS LOG

SMITH  
A34  
7-10-70

July 10 1970 W. G. Butler Smith  
date well completed firm name county well located

LANDOWNER:  
Vernon Beatty  
Palkville, Miss.  
(mailing address)

description of formations encountered	from	to
Clay + Sand	0	41
Clay	41	318
Rock	318	321
Clay	321	369
Sand + Shell	369	432
Sand clay Lignite	432	474
Sand	474	620
Sand + clay	620	641

WELL LOCATION:  
sec. 1 T. 4 (N) R. 6 (E)  
5 miles NE of Palkville  
(distance) (direction) (nearest town)

WELL PURPOSE:  
(home, irrigation, municipal, industrial)

WELL COMPLETION DATA:

(1) diameter (inches) 2"

(2) total depth (feet) 641

(3) static water level (feet) \_\_\_\_\_ below above top of ground.

(4) casing galv. 610' (material) (depth)  
2" (size) if telescope see back.

(5) screen 20' 610' (length) (depth to top)  
2" (size) S.S. (material)

(6) pump Air Comp. (HP) (yield gpm)  
Electric. (type power)

(7) electric log No (yes or no)

(organization running log)

(8) how well bottom plugged 2" Blw.

**CODED**


AWG 6 1970

DRILLERS REMARKS:

MISS. BD. OF  
WATER COM.

If well telescopes please sketch and show depths.

GROUND LEVEL

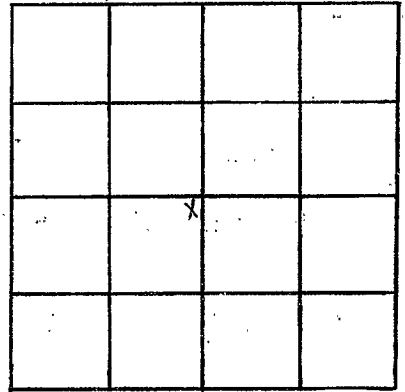

SECTION 1

Please indicate well location X.

ADDITIONAL INFORMATION

If more than one screen,  
show locations of each on sketch.