

SMITH
A35

12-1-70

MISSISSIPPI
BOARD OF WATER COMMISSIONERS
416 North State Street
Jackson, Mississippi 39201

CODED

WATER WELL DRILLERS LOG

Dec-9 1970 W.G. Butler Smith
date well completed firm name county well located

LANDOWNER:
Johnnie Paul Adcock
Polkville, Miss
Rt 1 (mailing address)

description of formations encountered	from	to
Clay	0	20
Clay + Fine Sand	20	40
Clay	40	70
Rock + Clay	70	100
Rock - Clay + Hard Lignite	100	140
Clay + Sand	140	157
Sand	157	160
Clay + Lignite	160	180
Sand	180	185
Clay + Sand	185	190
Clay	190	200
Sand	200	220
Sand + Clay	220	230

WELL LOCATION:
sec. 10 T. 4 N. R. 6 E. S. 5 W.
2 1/2 miles N of White Oak
(distance) (direction) (nearest town)

WELL PURPOSE: HOME
(home, irrigation, municipal, industrial)

WELL COMPLETION DATA:

(1) diameter (inches) 2"

(2) total depth (feet) 230

(3) static water level (feet) 54 ^{below} _{above} top of ground.

(4) casing galv. 2 1/2"
(material) (depth)
2" if telescope see back.
(size)

(5) screen 5' 2 1/2"
(length) (depth to top)
2 1/2" SS.
(size) (material)

(6) pump 3/4 5
(HP) (yield gpm)
Electric
(type power)

(7) electric log No
(yes or no)

(organization running log)

(8) how well bottom plugged 2" BWV

CODED


DEC 14 1970

MISS. Bd. OF
WATER COMM.

DRILLERS REMARKS:

If well telescopes please sketch and show depths.

GROUND LEVEL

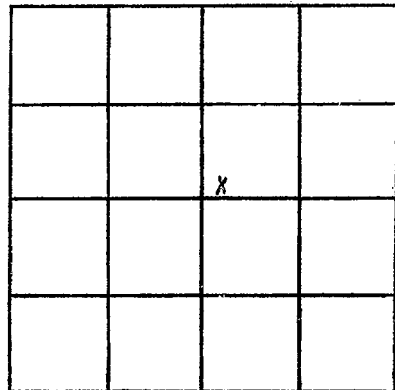

SECTION 10

Please indicate well location X.

ADDITIONAL INFORMATION

If more than one screen, show locations of each on sketch.