

SMITH
A-36
7-15-71

MISSISSIPPI
BOARD OF WATER COMMISSIONERS
416 North State Street
Jackson, Mississippi 39201

CODED

WATER WELL DRILLERS LOG

July 15 1971 *K. E. Thompson* *Smith*
date well completed firm name county well located

LANDOWNER:	description of formations encountered	from	to
<i>Sam Pasick</i>			
<i>Palmyra</i> (mailing address)	<i>red sand</i>	<i>10</i>	<i>25</i>
WELL LOCATION: sec <i>31</i> T <i>4</i> N R <i>6</i> E <i>3</i> miles <i>S</i> of <i>Palmyra</i> (distance) (direction) (nearest town)	<i>White clay</i>	<i>45</i>	<i>47</i>
WELL PURPOSE: <i>home</i> (home, irrigation, municipal, industrial)			
WELL COMPLETION DATA:			
(1) diameter (inches) <i>2"</i>			
(2) total depth (feet) <i>47'</i>			
(3) static water level (feet) <i>24</i> below top of ground.			
(4) casing <i>Plastic, 46'</i> (material) (depth) <i>2"</i> (size) if telescope see back.			
(5) screen <i>2" x 5"</i> , <i>40'</i> (length) (depth to top) <i>#.006</i> , <i>Plastic</i> (size) (material)			
(6) pump <i>1/2</i> <i>4</i> (HP) (yield gpm) <i>Just</i> (type power)			
(7) electric log <i>not</i> (yes or no) (organization running log)			
(8) how well bottom plugged <i>plugged</i>			
DRILLERS REMARKS:			


CODED

AUG 13 1971

MISS. BD. OF
WATER COMM.

If well telescopes please sketch and show depths.

GROUND LEVEL

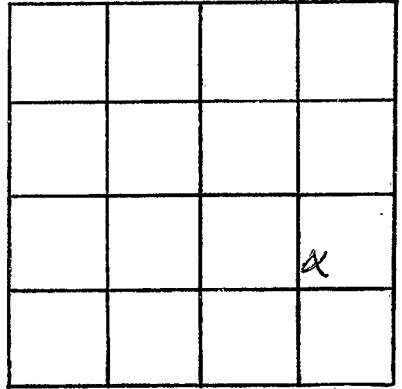

SECTION 31

Please indicate well location X.

ADDITIONAL INFORMATION

If more than one screen,
show locations of each on sketch.