

SMITH
A 38
3-77
E Log # 180
MAR.

MISSISSIPPI
BOARD OF WATER COMMISSIONERS
416 North State Street
Jackson, Mississippi 39201

CODED

WATER WELL DRILLERS LOG

1977 GRINER DRILLING SERVICE SMITH
date well completed firm name county well located

LANDOWNER: POLKVILLE
WATER ASSOCIATION, WELL
No. 2
(mailing address)

WELL LOCATION: NEAR SW 1/4 SW 1/4
sec. 9 T. 4 N. R. 6 E. S. W.
(distance) miles (direction) of (nearest town)

WELL PURPOSE:
(home, irrigation, municipal, industrial)

- WELL COMPLETION DATA:
- (1) diameter (inches) 10³/₄
 - (2) total depth (feet) 1,127
 - (3) static water level (feet) 297 (below top of ground)
 - (4) casing Bit. 1063 (material) (depth)
10³/₄ (size) If telescope see back.
 - (5) screen 50' 1077 (length) (depth to top)
6 304 S.S. (size) (material)
 - (6) pump 40 200 (HP) (yield gpm)
Elect (type power)
 - (7) electric log Yes (yes or no)
MGS (organization running log)

description of formations encountered	from	to
CLAY + streaks of SAND	0	110
CLAY	110	580
SAND fine	580	637
CLAY w/ SAND streaks	637	770
CLAY + ROCKS	770	950
CLAY + SAND STREAKS	950	1010
SAND	1010	1062
CLAY	1062	1076
SAND	1076	1130
CLAY	1130	1174
SAND	1174	1250
SAND w/ CLAY streaks	1250	1300
CLAY + ROCKS (HARD)	1300	1330

CODED

CODED

RECEIVED

MAR 18 1977


DRILLERS REMARKS:

BACK
WASH VALVE

(X)

If well telescopes please
sketch and show depths.

GROUND LEVEL

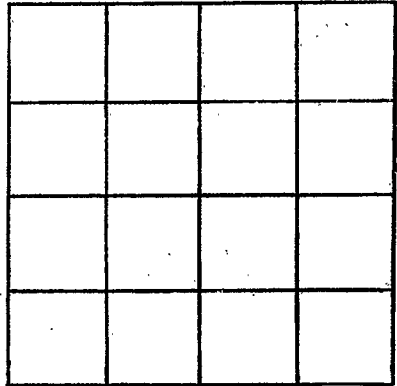

SECTION _____

Please indicate well location X.

ADDITIONAL INFORMATION

Lined area for additional information.

If more than one screen,
show locations of each on sketch.