

SMITH
A 40
1/5/78

MISSISSIPPI
BOARD OF WATER COMMISSIONERS
416 North State Street
Jackson, Mississippi 39201

CODED


WATER WELL DRILLERS LOG

1/5/78 19 Griffin Drilling Service Smith Co. Ms.
date well completed firm name county well located

LANDOWNER: <u>Exchange Oil & Gas</u>	description of formations encountered	from	to
<u>Pa.</u>			
<u>SR. Richardson # 1</u> (mailing address)	<u>clay + sand</u>	<u>0</u>	<u>21</u>
	<u>Clay</u>	<u>22</u>	<u>500</u>
	<u>Steel, Sand, Clay</u>	<u>501</u>	<u>620</u>
	<u>Sandstone</u>	<u>621</u>	<u>672</u>
	<u>Stratified clay + sand</u>	<u>673</u>	<u>740</u>
WELL LOCATION: sec. <u>22</u> T. <u>4</u> N. R. <u>6</u> E <u>700'</u> S + <u>2050'</u> W of NE Cor. W (distance) miles (direction) of (nearest town)			
WELL PURPOSE: (home, irrigation, municipal, <u>Industrial</u>)			
WELL COMPLETION DATA:			
(1) diameter (inches) <u>3"</u>			
(2) total depth (feet) <u>740'</u>			
(3) static water level (feet) <u>140</u> <u>below</u> above top of ground.			
(4) casing <u>Steel</u> <u>672'</u> (material) (depth)			
(size) If telescope see back.			
(5) screen <u>40'</u> <u>632'</u> (length) (depth to top)			
<u>3"</u> <u>Perforated Pipe</u> (size) (material)			
(6) pump <u>75</u> (HP) (yield gpm)			
<u>AC</u> (type power)			
(7) electric log <u>NO</u> (yes or no)			
(organization running log)			
(8) how well bottom plugged <u>orange</u> <u>fill</u>			
DRILLERS REMARKS: <u>Jackie Shultz</u>			
RECEIVED JAN 17 1978			
MISS. BD. OF WATER COMM			

If well telescopes please sketch and show depths.

GROUND LEVEL

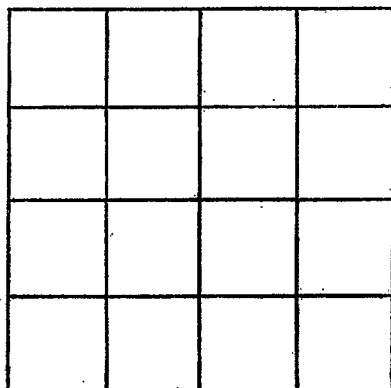

SECTION _____

Please indicate well location X.

ADDITIONAL INFORMATION

If more than one screen, show locations of each on sketch.