
	л		137			
allice	State Well Report		For Office Use Only:			
all.		Part 1				
	Mississippi Departmen	nt of Environmental Quality	Aquifer: Well #: $A - 43$			
		Office of Land and Water Resources P.O. Box 10631 Well #:				
Mailing	Driller: / atthews Noylling Anc.	AS 39289-0631	L. S. Elevation:			
· · ·)961-5210 54-6938 (fax)	E-log #:			
No	(001)33	•				
Nere is L	State Law requires that this report be prepared by the driller in detail and filed with the Department within 30 days of completion of drilling of the well.					
	Well Owner Information	Wel	Well Location			
Mot e well Texas	Owner Name Kinnel Smith	Latitude:''	_" Longitude:^"			
\sim	Mailing Address: 203 Sammy Joe Rodd	Method of Lat/Long (circle one): Conventional Survey,				
	,	USGS quad, Hand-held	d GPS, Survey-grade GPS			
strong	Lumberton M25 39455	NE 1/4 SE 1/4 Sec 2 Twn 25 Rng 13 W				
1 July	<u>Lumbertin</u> Ms <u>39455</u> City State Zip Code					
yVt	Telephone No. (601) 795 - 90.76	Distance Direction	of Miggins			
1, y 2	Telephone No. $(\underline{\mathcal{O}}, \underline{\mathcal{O}}, \mathcal{$					
vell . tarm	Well	Data	_			
Mite The a the work of the	Purpose of Well (circle one) Home Industrial Public Supply Irrigation Fish Culture Other:					
	Date well drilling started: <u>8/19/04</u> Date well drilling completed: <u>8/20/04</u> RECEIVED					
	If flowing, method of flow regulation: Valve Other (describe) Other (describe) 0/2004					
	Static Water Level: 60 feet above or below (circle one) land surface Date measured: 8/20/04 BY: 011115					
	Method of Measurement (circle one) steel tape electric tape air line other:					
	Hole depth: <u>180</u> Well depth: <u>180</u> Well grouted to a depth of <u>10</u> feet					
	Type of grout (circle one): Cement Bentonite Mix					
	Casing length: <u>160</u> feet Casing diameter: <u>4</u>	inches Type of casing:	PVC. 40			
	Screen length: <u>20</u> feet Screen diameter: <u>4</u>					
	Screen slot size: <u>12</u> inches Setting depth: From	feet to	190'feet			
	Type of completion (circle all applicable): Gravel packed Under	erreamed Telescoped Oper	n hole Natural Development			
	Other (describe):					
	Top of lap pipe or reduction in casing:feet. If	telescoped or more than one sc	reen, describe on back of page			
	Logs run (circle all applicable). No log run Electric Gamma Ray Density Sonic Neutron Other:					
	Name of organization running log(s):					
	I certify that the well was drilled, constructed, and completed in					
	Department of Environmental Quality and/or the Mississippi De	epartment of Health regulation	s and state laws.			
	John M. Matthewis # 690	lin ,	R. Millio			
	Print Name of Water Well Contractor and License No.	Signature of	of Water Well Contractor			

If well telescopes please sketch below and show depths.

round Level	A-43	Description of Formations Encountered	From	То
	/	Clay	0	20'
		Sand	20	65
		Clay.	65	140
		sand	140	180
		-444		
				1
		······		1
				+
		······································		+
				+
				-
	1			

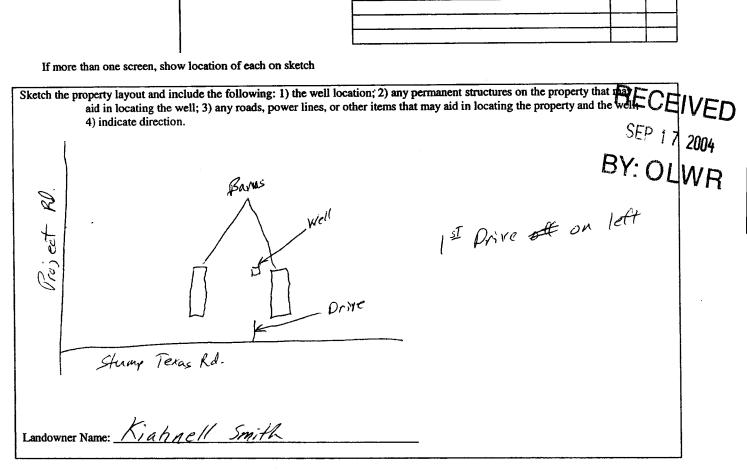

Signature of Water Well Contractor

County: Store	Pump Installer	Part 2 "'s Completion Report ent of Environmental Quality	For Office Use Only: Aquifer: Well #: <u>A-43</u>	
Permit #: Driller: <u>Matthens Distling</u> In.	Office of Land P.O.	l and Water Resources . Box 10631		
Date completed:	Jackson, MS 39289-0631 (601)961-5210 (601)354-6938 (fax)		Well #:	
This report should be prepared by installation of pump.	the pump installer in det	ail and filed with the Departme	ent within 30 days of the	
Well Owner Inform	nation	Well Location		
Owner Name: Kighnell Smith		Latitude:	Latitude: Longitude:	
Mailing Address: 203 Samm	r Joe Road	Method of Lat/Long (circle one): Conventional Survey,		
<u></u>			d-held GPS, Survey-grade GPS	
<u>Lumbertan Ms</u> City Stat	<u>5</u> 39455 e Zip Code	NE 14 SE 14 Sec_2	7	
		Distance Direction		
Telephone No. (601) 795 - 90	076	6 Miles East of Migyins		
Ритр Туре		Power Type Circle one		
Circle one				
Air Lift Jet	Submersible		ine Engine Natural Gas	
Bucket Piston	Turbine	Electric Motor Hand	Tractor PTO	
Centrifugal Rotary	Flowing Well		(specify):RECE	
Other (specify):		Horse Power Rating of Moto	1.10.0	
Date Pump Installed: 8/20/04		Setting Depth: <u>120'</u> feet ²⁵⁴ 17		
Rated Pump Capacity:	Gallons Per Minute	Number of Stages:	<u>3 By: OL</u>	
Pump Test Data			easuring Water Level Circle one	
Date Well Tested:				
Static Water Level (A): <u>60</u> Fe	eet Below Land Surface		asuring Line Steel Tape	
Pumping Water Level (B):Fe	et Below Land Surface	Outer (specify):		
Drawdown [(B) - (A)]:F	eet Below Land Surface	For flowing well, measured s	hut in head:feet	
Test Pumping Rate:	Gallons Per Minute		GPM with a drawdown of	
Duration of Pump Test (minimum 4 hour	rs): <u> </u>	<u>40</u> feet after	۲/hours of pumping	
		of my knowledge.		