

STATE WELL REPORT

Part 1

Driller's Log

Mississippi Department of Environmental Quality
Office of Land and Water Resources
P.O. Box 2309
Jackson, MS 39225-2309
(601)961-5210
(601)360-0535 (fax)

County: Smith
Permit #: _____
Driller: Keith Parker
Date drilling completed: 6-12-18

For Office Use Only:

Well #: A52
Aquifer: _____
E-Log #: _____

State Law requires that this report be prepared by the license holder responsible for the work and filed with the Department at the above address within 30 days of completion of drilling of the well or borehole.

Well Owner Information <small>(Landowner if borehole is not for a water well)</small>	Well or Borehole Location
Owner Name: <u>Lee Traxler</u>	Latitude: <u>32 12 21.4N</u> Longitude: <u>89 29 08.3W</u>
Mailing Address: _____	Method of Lat/Long (check one): Conventional Survey _____, USGS quad _____, Hand-held GPS <input checked="" type="checkbox"/> , Survey-grade GPS _____
<u>Polkville MS 39168</u>	<u>NW 1/4 - NE 1/4, Sec 11 - T 4N R 6E</u>
City State Zip Code	<u>5</u> Miles <u>East</u> of <u>Polkville</u>
Telephone No. <u>(601) 537 3271</u>	(Distance) (Direction) (Nearest Town)

Well / Borehole Data	
Date drilling started: <u>6-7-18</u> Date drilling completed: <u>6-12-18</u> Hole depth: <u>600</u> Hole diameter: <u>6 1/2</u>	
Location of the source of any surface water used for drilling: _____	
Method of dosing and volume of Chlorine used in drilling and development: <u>2 gal per 1000</u>	
Logs run (circle all applicable): No log run <input type="checkbox"/> Electric <input type="checkbox"/> <u>Gamma Ray</u> <input type="checkbox"/> Density <input type="checkbox"/> Sonic <input type="checkbox"/> Neutron <input type="checkbox"/> Other: _____	
Name of organization running log(s): <u>MDEQ</u>	
Purpose of borehole (circle one) <u>Water Well</u> <input type="checkbox"/> Geotechnical/Geological Investigation <input type="checkbox"/> Ground Source Heat Pump <input type="checkbox"/> Seismic Survey <input type="checkbox"/> Other (describe) _____	
<i>If drilling is not related to water well construction, skip the remainder of this block</i>	
Purpose of Well (circle all applicable): Home <input type="checkbox"/> Industrial <input type="checkbox"/> Public Supply <input type="checkbox"/> Irrigation <input type="checkbox"/> Fish Culture <input type="checkbox"/>	
Other (describe): <u>Chicken Farm</u>	
If a flowing well, method of flow regulation: Valve _____ Other (describe) _____	
Static Water Level: <u>180</u> feet [above or below] land surface Date measured: <u>6-15-18</u> <small>(circle one)</small>	
Method of measurement (circle one): <u>Steel tape</u> <input type="checkbox"/> Electric tape <input type="checkbox"/> Air line <input type="checkbox"/> Other (describe) _____	
Well depth: <u>600</u> Well grouted to a depth of: <u>10</u> feet Type of grout (circle one): <u>Neat Cement</u> <input type="checkbox"/> Bentonite <input type="checkbox"/> Mix <input type="checkbox"/>	
Casing length: <u>500</u> feet Casing diameter: <u>4</u> inches Type of casing: _____	
Screen length: <u>20</u> feet Screen diameter: <u>2</u> inches Type of screen: <u>SS</u>	
Screen slot size: _____ inches Setting depth: From _____ feet to _____ feet	
Type of completion (circle all applicable): Gravel packed <input type="checkbox"/> Underreamed <input type="checkbox"/> Open hole <input type="checkbox"/> <u>Natural Development</u> <input type="checkbox"/>	
Other (describe): _____	
Top of lap pipe or reduction in casing: <u>440</u> feet	

If telescoped or more than one screen, describe on next page

RECEIVED
JUL 24 2018
BY OLWR


County: Smith
Permit #: _____

For Office Use Only:
Well #: A52

The sketch below only required for water wells

Description of formations encountered must be provided for all wells and boreholes, unless specifically exempted by regulations


If well telescopes, show depths on sketch.

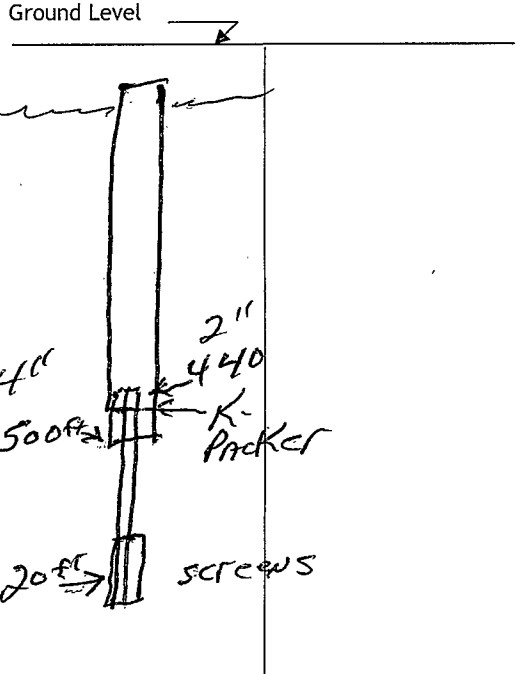

Description of Formations Encountered	From (depth)	To (depth)
SAUD	Ground level	40
CLAY	40	380
SAUD	380	390
SHALE	390	420
SAUD	420	470
SHALE	470	530
SAUD	530	580

If more than one screen, show location of each on sketch

- Sketch the property layout and include the following:
- 1) the well location
 - 2) any permanent structures on the property that may aid in locating the well
 - 3) any roads, power lines, or other items that may aid in locating the property and the well
 - 4) north arrow

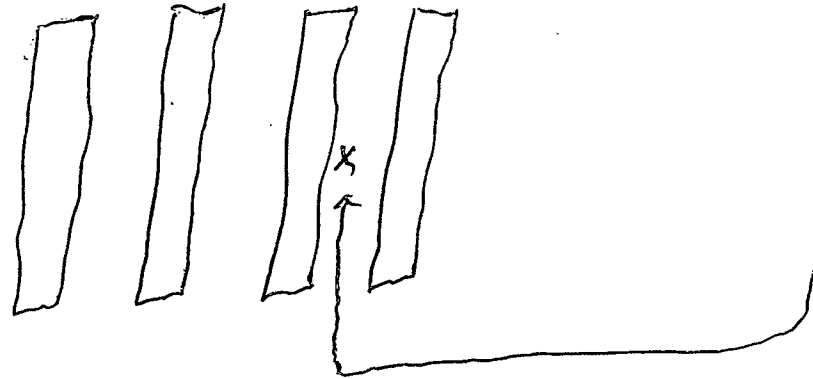

RECEIVED
JUL 24 2018
BY OLWR

Landowner Name: _____

I HEREBY CERTIFY that the well/borehole was drilled, constructed, and completed in accordance with all applicable requirements of the Mississippi Department of Environmental Quality and the Mississippi Department of Health regulations, if applicable, and state laws.

Keith Parker 7462 7-19-18 Keith Parker
Print Name of Responsible Licensee and License No. Date Signature of Licensee

STATE WELL REPORT

Part 2

Pump Installer's Completion Report

Mississippi Department of Environmental Quality
Office of Land and Water Resources
P.O. Box 2309
Jackson, MS 39225-2309
(601)961-5210
(601) 360-0535 (fax)

County: Smith
Permit #: _____
Driller: Keith Parker
Date completed: 6-15-18
Copy information from block on Part 1

For Office Use Only:

Well #: A52
Aquifer: _____

This part of the report must be completed by a licensed water well contractor or a licensed pump installer. A copy of Part 1 of the report must be attached and both parts filed with the Department at the above address within 30 days of well completion.

Well Owner Information	Well Location
Owner Name: <u>Lee Traxler</u>	Latitude: <u>32 12 21.4 N</u> Longitude: <u>89 29 08.3 W</u>
Mailing Address: _____	Method of Lat/Long (check one): Conventional Survey _____, USGS quad _____, Hand-held GPS <input checked="" type="checkbox"/> , Survey-grade GPS _____
<u>Polkville</u> <u>MS</u>	<u>NW</u> ¼ <u>NE</u> ¼, Sec <u>11</u> T. <u>4N</u> R. <u>6E</u>
City State Zip Code	<u>5</u> Miles <u>E</u> of <u>Polkville</u>
Telephone No. <u>(601) 537 3271</u>	(Distance) (Direction) (Nearest Town)

Pump Type (circle one)

Submersible Turbine Air Lift Centrifugal Flowing Well Jet Piston Rotary Other (describe): _____

Date Pump Installed: 6-15-18 Rated Pump Capacity: 30 Gallons Per Minute

Is This Pump (circle one): New Repaired Replacement

Power Type (circle one)

Electric Diesel Gasoline Natural Gas Tractor PTO Windmill Other (describe): _____

Horse Power Rating of Motor: 5 Setting Depth: 252 feet Number of Stages: 12

Pump Test Data for Non Flowing Well

Date Well Tested: 6-15-18 Duration of Pump Test (minimum 4 hours): 8 hours

Static Water Level (A): 180 Feet Below Land Surface Pumping Water Level (B): 230 Feet Below Land Surface

Drawdown [(B) - (A)]: 50 Feet Below Land Surface Test Pumping Rate: _____ Gallons Per Minute

Method of measurement (circle one): Steel tape Electric Tape Air line Other (describe): _____

Pump Test Data for Flowing Well

Measured shut in head: _____ feet.

Well yielded _____ GPM with a drawdown of _____ feet after _____ hours of pumping

Meter Installation

Meter Manufacturer: _____ Meter Serial Number: _____

Meter Model Number/Name: _____ Type of Meter: _____

Totalizer Register Unit and Multiplier Factor (AF x .001, gal x 1000, etc): _____

Installation Date: _____ Meter installed by: _____

Is This Meter (circle one): New Repaired Replacement

Important: By submitting the above information you are certifying that this meter was installed to manufacturer standards. For agricultural wells, a list of approved meters is on the MDEQ website.

I HEREBY CERTIFY that the above statements are true to the best of my knowledge.

Keith Parker 02402 2-19-18 Keith Parker

Print Name of Pump Installer and License No. (if applicable) Date Signature of Pump Installer

RECEIVED
JUL 24 2018
BY OLWR