

MISSISSIPPI DEPARTMENT OF NATURAL RESOURCES

Bureau of Land and Water Resources

Southport Mall

P.O. Box 10631

Jackson, Mississippi 39209

WATER WELL DRILLERS LOG

SMITH  
A 2000

10-27-83 McDonald & Hill Smith  
 date well completed firm name county well located

LANDOWNER:	description of formations encountered	from	to
<u>John Richardson</u> <u>Forcin</u> (mailing address)			
<b>WELL LOCATION:</b> sec. <u>13</u> T <u>4</u> <sup>S</sup> R. <u>6</u> <sup>E</sup> <u>8</u> miles <u>W</u> of <u>Forcin</u> (distance) (direction) (nearest town)	<u>shale + st Rock</u>	<u>270</u>	<u>325</u>
<b>WELL PURPOSE:</b> <u>none</u> (home, irrigation, municipal, industrial)	<u>Randy shale shells</u>	<u>325</u>	<u>350</u>
<b>WELL COMPLETION DATA:</b>	<u>shale + sand</u>	<u>350</u>	<u>400</u>
(1) diameter (inches) <u>4 x 3</u>	<u>fine sand</u>	<u>400</u>	<u>450</u>
(2) total depth (feet) <u>470</u>	<u>med sand</u>	<u>450</u>	<u>470</u>
(3) static water level (feet) <u>40'</u> below top of ground.			
(4) casing <u>PVC</u> , <u>260</u> , (material) (depth) <u>4"</u> <u>210'</u> <u>2"</u> <u>Black</u> (size) if telescope see back.			
(5) screen <u>5</u> , <u>445 to 450</u> (length) (depth to top) <u>3"</u> , <u>SS</u> (size) (material)			
(6) pump <u>1</u> , <u>800 M.</u> (HP) (yield gpm) <u>R</u> (type power)			
(7) electric log <u>—</u> (yes or no)  (organization running log)			
(8) how well bottom plugged <u>value</u>			
<b>DRILLERS REMARKS:</b> <u>Seal set at 231'</u>			


DEPT. OF NATURAL RESOURCES  
 BUREAU OF LAND & WATER RESOURCES

NOV - 7 1983

RECEIVED

If well telescopes please sketch and show depths.

GROUND LEVEL

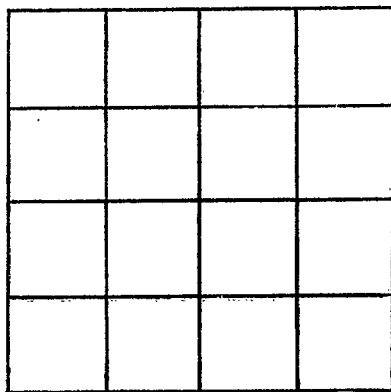

SECTION \_\_\_\_\_

Please indicate well location X.

ADDITIONAL INFORMATION

If more than one screen,  
show locations of each on sketch.