

SMITH MISSISSIPPI BOARD OF WATER COMMISSIONERS T

3 B | 5-24-63

WATER WELL DRILLERS LOG

97.8

Date: 5/24, 1963, Driller Frank Drey Att County  
 (Name)

(1) Owner of Land: W. C. Phipps  
 (Name)  
Greaton, Miss.  
 (Address)  
 (2) Location: NW 1/4, NE 1/4, Sec. 17 T14N R7E  
2 miles East of Greaton  
 (distance) (direction) (Nearest Town)  
 (3) Topography: X  
 (Hilly) (Flat) (Level)  
 (4) Purpose of Well: chickens  
 (Domestic Irrigation  
 Municipal, Industrial, Other)


Description & Color of Materials Sand, Clay, Red Clay, Shell, etc.	Thick- ness Feet	Depth Feet
Clay	0	5
Clay + red sand		12
Sand + clay		22
Blue Clay		42
fine sand + shls Clay		52
Clay		72
Clay + shls rock		82
Clay		192
Shale		342
Shale + shls rock		352
Shale		372
Shale + shls fine rock		392
Shell + shls rock		402
Shale		524
fine sand + shls clay		534
fine sand		542
Shale		550
Shale + shls sand		564
fine sand		580
Soft Shale		584

Information upon completion of well:

(1) Diameter 2" inches.  
 (2) Total Depth 582 feet.  
 (3) Water Level 120 feet below top of ground.  
 (4) Cased to 567, Size 2"  
 (5) Screen: Size 2", Length 15 ft.  
 (6) Were any formations sealed against pollution?  
 \_\_\_\_\_ yes, X no.

If YES depth of formation \_\_\_\_\_  
 Why Air Comp 3hp.

Drillers Remarks: Fe. Stron  
Hard

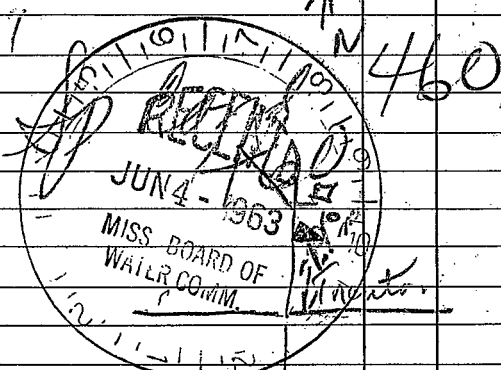

(Use Back Side)

Well No.

