

3 BZ
6-10-64

Schep

T

WATER WELL DRILLERS LOG

Date: June 10, 1964, Driller: W. G. Butler County Smith
(Name)

(1) Owner of Land: Arvin Bradshaw
(Name)
BURNS, MISS.
(Address)

(2) Location: 1/4, 1/4, Sec. 29^N R6E
IN Trenton, of (Nearest Town)
(distance) (direction)

(3) Topography: (Hilly) (Flat) (Level)

(4) Purpose of Well: Domestic
(Domestic Irrigation
Municipal, Industrial, Other)

Description & Color of Materials Sand, Clay, Red Clay, Shell, etc.	Thick- ness Feet	Depth Feet
Red clay	1-5	
Crumbly chalk	5-32	
Rock	32-40	
Blue chalk	40-50	
Fine sand + chalk	50-60	
Chalk + white	60-70	
Chalk + Bennite	70-80	
Crumbly chalk	80-90	
Crumbly sand	90-110	
Sand	110-117	0

Information upon completion of well:

(1) Diameter 2 inches.


(2) Total Depth 117 feet.

(3) Water Level 90 feet below top of ground.

(4) Cased to 147', Size 2"

(5) Screen: Size 20", Length 10'


(6) Were any formations sealed against pollution?
no.

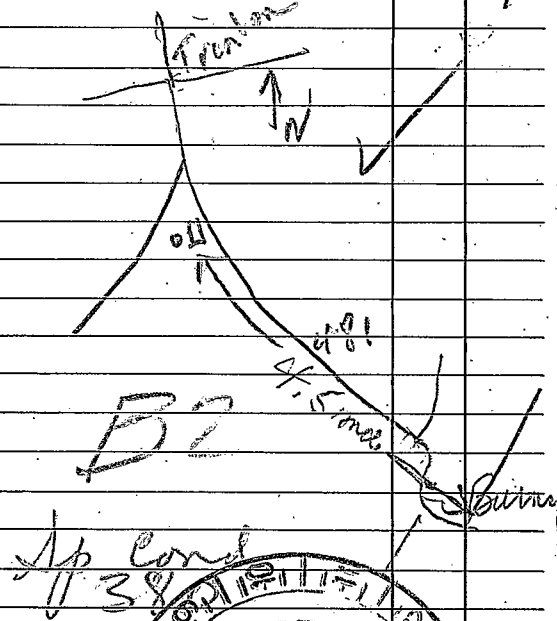

If YES depth of formation _____

Why _____

Drillers Remarks: Iron Jet Pump 2hp

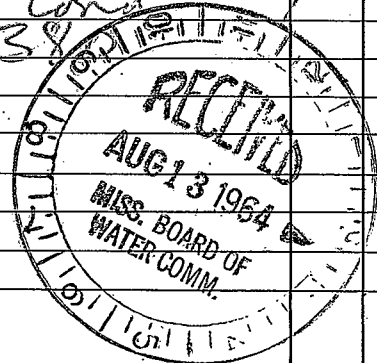

(Use Back Side)

Well No.

