

SMITH MISSISSIPPI BOARD OF WATER COMMISSIONERS

WATER WELL DRILLERS LOG

5 B5
3-9-66

T

Date Mar 9, 1966 Driller: W. G. Butler County Smith
(Name)

(1) Owner of Land: S. L. STUART
(Name)
Pulaski, Miss
(Address)

(2) Location: 1/4, 1/4, Sec. 19 T4 R9E
5 miles S of Polkville
(distance) (direction) (Nearest Town)

(3) Topography: (Hilly) (Flat) (Level)

(4) Purpose of Well: Domestic
(Domestic Irrigation
Municipal, Industrial, Other)

Description & Color of Materials Sand, Clay, Red Clay, Shell, etc.	Thick- ness Feet	Depth Feet
Red Clay + Chalk	1	10
Chalk + Limestone	18	28
gray Chalk	20	48
Limestone + Chalk	30	78
Fine Sand	38	118
Chalk	40	158
Sand	60	218

Information upon completion of well:

(1) Diameter 2' inches.

(2) Total Depth 80 feet.

(3) Water Level _____ feet below top of ground.

(4) Cased to 69', Size 2"


(5) Screen: Size 2", Length 10"

(6) Were any formations sealed against pollution?
_____ yes, _____ no.

If YES depth of formation _____

Why _____

Drillers Remarks: _____

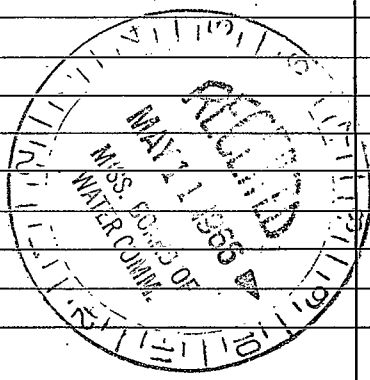

(Use Back Side)

Well No.

1911

...

...

...

...