

SMITH
B 6
3-68

MISSISSIPPI
BOARD OF WATER COMMISSIONERS 082
416 North State Street
Jackson, Mississippi 39201

WATER WELL DRILLERS LOG

3-20 19-68 Wilkerson Drilling Spirit 6
date well completed firm name county well located

LANDOWNER: Mr. A B Black

description of formations encountered	from	to
	Red + Yellow Clay	0
SAND + CLAY	18	105
Blue clay	105	180
Rock	180	182
Blue clay	182	380
FINE SAND	380	400
Shale Rock	400	420
SHALE + FINE SAND	420	508
Shale + FINE SAND + Shale	508	666
Rock	666	670
SAND	670	684
SAND	684	691
Shale	691	704

Forest, Miss

(mailing address)


WELL LOCATION:

sec 3 T 4 N R 7 E
7 miles S.W. of Homewood
(distance) (direction) (nearest town)

WELL PURPOSE: home
(home, irrigation, municipal, industrial)

WELL COMPLETION DATA:


- (1) diameter (inches) 2
- (2) total depth (feet) 684
- (3) static water level (feet) 200 ^{below}/_{above} top of ground.
- (4) casing GALV. (material), (depth)
2 (size) If telescope see back.
- (5) screen 12 (length), (depth to top)
2 (size), Brass (material)
- (6) pump 5 (HP), 14 (yield gpm)
Elec (type power)
- (7) electric log NO (yes or no)
(organization running log)
- (8) how well bottom plugged 2-2" B.W.G.

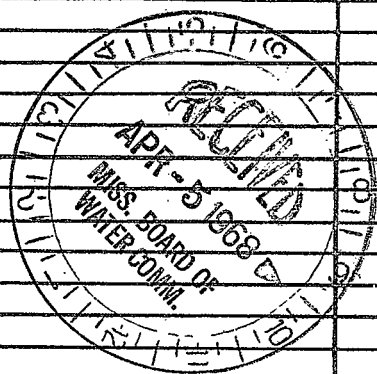

DRILLERS REMARKS:

If well telescopes please sketch and show depths.

GROUND LEVEL

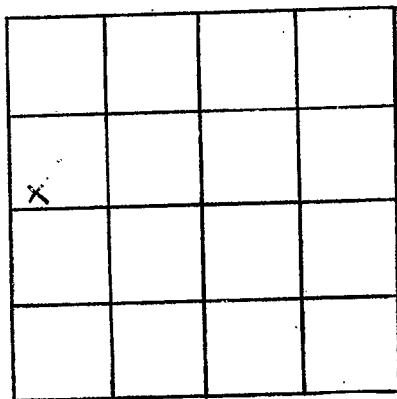

SECTION 3

Please indicate well location X.

ADDITIONAL INFORMATION

If more than one screen, show locations of each on sketch.